


15-051-01250-00-01

STATE OF KANSAS
STATE CORPORATION COMMISSION

Form CP-4

Give All Information Completely
Make Required Affidavit
Mail or Deliver Report to:
Conservation Division
State Corporation Commission
P. O. Box 17027
Wichita, Kansas 67217
NORTH

WELL PLUGGING RECORD

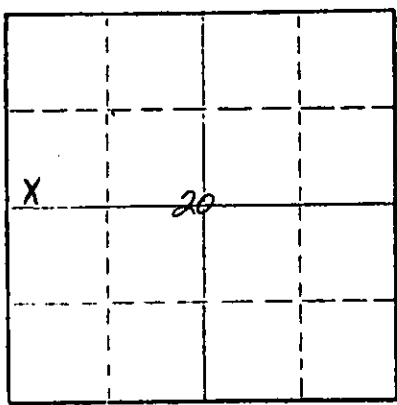

Locate well correctly on above
Section Plat

Ellis County, Sec. 20 Twp. 13S Rge. 20 (W)
Location as "NE/CNW/SW" or footage from lines C SW SW NW
Lease Owner Zenith Drilling Corp., Inc.
Lease Name BITTEL Well No. #1
Office Address 200 W. Douglas, Wichita, Kansas 67202
Character of Well (completed as Oil, Gas or Dry Hole) Dry Hole
Date well completed February 2 1975
Application for plugging filed (verbally) February 2 1975
Application for plugging approved (verbally) February 2 1975
Plugging commenced February 2 1975
Plugging completed February 2 1975
Reason for abandonment of well or producing formation No Commercial Quantities
of Oil or Gas Encountered.
If a producing well is abandoned, date of last production 19
Was permission obtained from the Conservation Division or its agents before plugging was commenced? Yes

Name of Conservation Agent who supervised plugging of this well Leo Massey
Producing formation _____ Depth to top _____ Bottom _____ Total Depth of Well 3940' Feet
Show depth and thickness of all water, oil and gas formations.

OIL, GAS OR WATER RECORDS

CASING RECORD

FORMATION	CONTENT	FROM	TO	SIZE	PUT IN	PULLED OUT

Describe in detail the manner in which the well was plugged, indicating where the mud fluid was placed and the method or methods used in introducing it into the hole. If cement or other plugs were used, state the character of same and depth placed, from _____ feet to _____ feet for each plug set.


1st Plug Set @ 600' with 70 sacks Cement
2nd Plug Set @ 180' with 20 sacks Cement
3rd Plug Set @ 40' with 10 sacks Cement

RECEIVED
STATE CORPORATION COMMISSION
1/18/75
12-10-1975
CONSERVATION DIVISION
Wichita, Kansas

(If additional description is necessary, use BACK of this sheet)
Name of Plugging Contractor Abercrombie Drilling, Inc.
Address 801 Union Center, Wichita, Kansas 67202

STATE OF KANSAS, COUNTY OF SEDGWICK, ss.
Jerry A. Langrehr (employee of owner) or (owner or operator) of the above-described well, being first duly sworn on oath, says: That I have knowledge of the facts, statements, and matters herein contained and the log of the above-described well as filed and that the same are true and correct. So help me God.

(Signature) Jerry A. Langrehr
801 Union Center, Wichita, Kansas 67202
(Address)

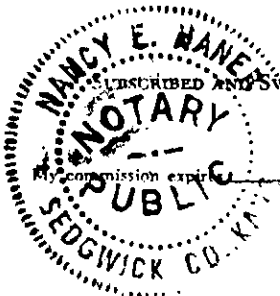

Described and sworn to before me this 7th day of February, 1975.
Nancy E. Haner
Notary Public.