


15-051-20235-00-00

WELL PLUGGING RECORD

Give All Information Completely  
Make Required Affidavit  
Mail or Deliver Report to:  
Conservation Division  
State Corporation Commission  
212 No. Market  
Wichita, Kansas

NORTH

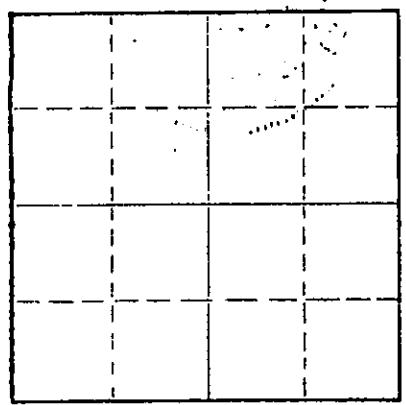

Locate well correctly on above  
Section Plat

Ellis County, Sec. 33 Twp. 13 Rge. 20 (E) (W)  
Location as "NE/CNW/SW" or footage from lines SE NE SW  
Lease Owner Chief Drilling Company  
Lease Name Rankin A# 2 Well No.  
Office Address Great Bend, Kansas 67530  
Character of Well (completed as Oil, Gas or Dry Hole)  
Date well completed 19  
Application for plugging filed 19  
Application for plugging approved 19  
Plugging commenced 10/28/68 19  
Plugging completed 10/30/68 19  
Reason for abandonment of well or producing formation depleted.

If a producing well is abandoned, date of last production 19  
Was permission obtained from the Conservation Division or its agents before plugging was commenced? yes

Name of Conservation Agent who supervised plugging of this well Massey  
Producing formation Depth to top Bottom Total Depth of Well 3918 Feet  
Show depth and thickness of all water, oil and gas formations.

OIL, GAS OR WATER RECORDS

CASING RECORD

| FORMATION | CONTENT | FROM | TO | SIZE   | PUT IN | PULLED OUT |
|-----------|---------|------|----|--------|--------|------------|
|           |         |      |    | 8-5/8  | 200'   | none       |
|           |         |      |    | 4 1/2" | 3916'  | 602'       |
|           |         |      |    |        |        |            |
|           |         |      |    |        |        |            |
Describe in detail the manner in which the well was plugged, indicating where the mud fluid was placed and the method or methods used in introducing it into the hole. If cement or other plugs were used, state the character of same and depth placed, from feet to feet for each plug set.

Checked bottom, pushed plug to 3500' and dumped 10 gallons sand.  
Ran 4 sacks of cement, Shot pipe at 3224', picked up on pipe,  
pipe parted, pulled 18 joints. Had welder weld on plate and 4"  
collar to squeeze well. Hooked up Allied and pumped 5 sacks hulls,  
25 sacks mud and 130 sacks of cement. Tallied pipe.

PLUGGING COMPLETE.

RECEIVED  
STATE CORPORATION COMMISSION  
NOV 7 1968  
CONSERVATION DIVISION  
Wichita, Kansas  
11-07-1968


(If additional description is necessary, use BACK of this sheet)  
Name of Plugging Contractor KNIGHT CASING PULLING CO., INC.  
Address CHASE, KANSAS

STATE OF KANSAS COUNTY OF RICE, ss.  
NOEL J. KNIGHT (employee of owner) or (owner or operator) of the above-described

well, being first duly sworn on oath, says: That I have knowledge of the facts, statements, and matters herein contained and the log of the above-described well as filed, and that the same are true and correct. So help me God.

(Signature) Noel Knight  
CHASE, KANSAS  
(Address)

Subscribed and sworn to before me this 4th day of November, 1968  
February 15, 1971  
My commission expires

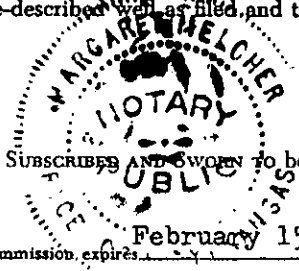

Margaret Melcher  
Notary Public.