

This form shall be filed in triplicate with the Kansas Corporation Commission, 200 Colorado Derby Building, Wichita, Kansas 67202, within ten days after the completion of the well, regardless of how the well was completed. Circle one: Oil, gas, dry, SWD, OWO, injection. Type and complete ALL sections. Applications must be filed for dual completion, commingling, salt water disposal and injection. Attach wireline logs (i.e. electrical log, sonic log, gamma ray neutron log, etc.) KCC#-(316)263-3238.

OPERATOR J. B. Collins

API NO. 15-195-20,924-00-00

ADDRESS 1007 Cody Ave. Suite A
Hays, KS 67601

COUNTY Trego

FIELD HIGA, So

**CONTACT PERSON Gloria Brown
PHONE 913-628-1046

PROD. FORMATION _____

PURCHASER _____

LEASE Locker

ADDRESS _____

WELL NO. 1

WELL LOCATION NE SE NW

DRILLING Dreiling Oil, Inc.

330 Ft. from east Line and

CONTRACTOR _____

990 Ft. from south Line of

ADDRESS Rt. #1


the SEC. 28 TWP. 13 RGE. 21 W

Victoria, KS 67671

PLUGGING _____

CONTRACTOR _____

ADDRESS _____

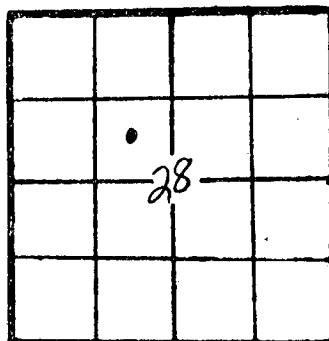

WELL PLAT

KCC _____
KGS _____
MISC _____
(Office Use)

TOTAL DEPTH 4110' PBTD _____

SPUD DATE 12-17-81 DATE COMPLETED 12-30-81

ELEV: GR 2333' DF 2335' KB 2338'

DRILLED WITH (CABLE) (ROTARY) (AIR) TOOLS _____

(New) / (Used) casing.

CASING RECORD

Report of all strings set — surface, intermediate, production, etc.

Purpose of string	Size hole drilled	Size casing set (in O.D.)	Weight lbs/ft.	Setting depth	Type cement	Socks	Type and percent additives
Surface pipe	12 1/4	8 5/8'		208'	common quick set	150	8 units quickset
Production	7 7/8	5 1/2'		4108'	common	150	8% salt 4% gilsonite 2% gel

LINER RECORD

PERFORATION RECORD

Top, ft.	Bottom, ft.	Socks cement	Shots per ft.	Size & type	Depth interval

TUBING RECORD

Size	Setting depth	Packer set at

ACID, FRACTURE, SHOT, CEMENT SQUEEZE RECORD

Amount and kind of material used

Date of first production _____ Producing method (flowing, pumping, gas lift, etc.) _____ Gravity _____

RATE OF PRODUCTION PER 24 HOURS
Oil _____ bbls. Gas _____ bbls. Water _____ % MCF

Disposition of gas (vented, used on lease or sold) _____ Perforations _____

**The person who can be reached by phone regarding any questions concerning this information. A witnessed initial test by the Commission is required if the well produces more than 25 BOPD or is located in a Basic Order Pool.

RECEIVED
STATE CORPORATION COMMISSION
FEB - 8 1982
CONSERVATION DIVISION
Wichita, Kansas
RECEIVED
STATE CORPORATION COMMISSION
SEP - 1 1982
CONSERVATION DIVISION
Wichita, Kansas

Name of lowest fresh water producing stratum _____ Depth _____

Estimated height of cement behind Surface Pipe 208'

DV USED? _____

WELL LOG

Formation Description, Contents, etc.	Top	Bottom	Name	Depth
Top soil, rock & sand	0'	80'		
Shale	80'	213'		
Shale & Sand	213'	420'		
Shale	420'	1320'		
Shale & Sand	1320'	1721'		
Anhy.	1721'	1767'		
Shale	1767'	1910'		
Shale	1910'	2410'		
Lime	2410'	2620'		
Lime & Shale	2620'	2810'		
Lime	2810'	3044'		
Lime & Shale Streaks	3044'	3240'		
Shale & Lime	3240'	3420'		
Lime	3420'	3500'		
Lime & Shale	3500'	3555'		
Lime & Shale	3555'	3664'		
Lime	3664'	3725'		
Lime	3725'	3727'		
Lime	3727'	3755'		
Lime	3755'	3820'		
Lime	3820'	3912'		
Lime	3912'	4032'		
Lime	4032'	4110'		
T.D.	4110'			

AFFIDAVIT

STATE OF KANSAS, COUNTY OF ELLIS SS,

John B. Collins OF LAWFUL AGE, BEING FIRST DULY SWORN UPON HIS OATH,

DEPOSES THAT HE IS Owner (FOR) (OF) B-J Oil Company

OPERATOR OF THE Locker LEASE, AND IS DULY AUTHORIZED TO MAKE

THIS AFFIDAVIT FOR AND ON THE BEHALF OF SAID OPERATOR, THAT WELL NO. 1 ON

SAID LEASE HAS BEEN COMPLETED AS OF THE --- DAY OF ---, 1982, AND THAT

ALL INFORMATION ENTERED HEREIN WITH RESPECT TO SAID WELL IS TRUE AND CORRECT.

FURTHER AFFIANT SAITH NOT. ~~THIS WELL IS TEMPORARILY ABANDONED~~

(S) John B. Collins

SUBSCRIBED AND SWORN BEFORE ME THIS 30th DAY OF August, 19 82

RECEIVED
NOTARY PUBLIC
STATE OF KANSAS
MY COMMISSION EXPIRES
7-15-84

GLORIA J. BROWN
NOTARY PUBLIC
STATE OF KANSAS
My Appt. Expires 7-15-84

Gloria Brown
NOTARY PUBLIC
STATE OF KANSAS

FEB - 8 1982
CONSERVATION DIVISION
Wichita, Kansas