

15-195-00921-00-00

STATE OF KANSAS
STATE CORPORATION COMMISSION

Form CP-4


WELL PLUGGING RECORD

Give All Information Completely
Make Required Affidavit
Mail or Deliver Report to:
Conservation Division
State Corporation Commission
211 No. Broadway
Wichita, Kansas

TREGO County. Sec. 23 Twp. 13S Rge. 21 (E) W(W)

Location as "NE/CNW&SW" or footage from lines. NW/4 NW/4 NW/4
Lease Owner BIRMINGHAM-BARTLETT DRILLING COMPANY
Lease Name ARNOLD "A" Well No. 2
Office Address 300 KAUFMAN BUILDING, WICHITA, KANSAS

NORTH

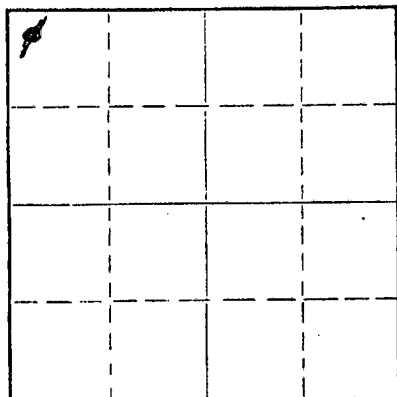

Locate well correctly on above
Section Plat

Character of Well (completed as Oil, Gas or Dry Hole)
Date well completed SEPTEMBER 10 19 63
Application for plugging filed NOVEMBER 4 19 65
Application for plugging approved 19
Plugging commenced NOVEMBER 5 19 65
Plugging completed NOVEMBER 10 19 65
Reason for abandonment of well or producing formation PRODUCTION TOO SMALL TO
BE PROFITABLE TO PRODUCE.

If a producing well is abandoned, date of last production AUGUST 30 19 65
Was permission obtained from the Conservation Division or its agents before plugging was com-
menced? YES

Name of Conservation Agent who supervised plugging of this well W. L. NICHOLS
Producing formation LANSING Depth to top 3567' Bottom Total Depth of Well 3973' Feet
Show depth and thickness of all water, oil and gas formations.

OIL, GAS OR WATER RECORDS

CASING RECORD

FORMATION	CONTENT	FROM	TO	SIZE	PUT IN	PULLED OUT
				8 5/8"	237'	NONE
				5 1/2"	3972'	3010.88'

Describe in detail the manner in which the well was plugged, indicating where the mud fluid was placed and the method or methods used
in introducing it into the hole. If cement or other plugs were used, state the character of same and depth placed, from feet to
feet for each plug set.

PBTD 3943'

3943'	-	3590'	-	SAND
3590'	-	3558'	-	4 SACKS CEMENT
3558'	-	600'	-	PUMPED 14 SACKS MUD
600'	-	540'	-	PUMPED 20 SACKS CEMENT
540'	-	240'	-	MUD
240'	-	180'	-	PUMPED 20 SACKS CEMENT
180'	-	40'	-	MUD
40'	-	30'	-	ROCK BRIDGE
30'	-	BASE	-	10 SACKS CEMENT

RECEIVED
STATE CORPORATION COMMISSION

DEC 7 1965 12.07.65

CONSERVATION DIVISION
WICHITA, KANSAS

(If additional description is necessary, use BACK of this sheet)

Name of Plugging Contractor SANTA-FE PIPE & SUPPLY, INC.
Address P. O. BOX 562 - GREAT BEND, KANSAS

STATE OF KANSAS COUNTY OF SEDGWICK
Chas. H. Keevert, Prod. Supt. of Birmingham-Bartlett Drilling Co., ss. owner & operator
(employee of owner) or (owner or operator) of the above-described
well, being first duly sworn on oath, says: That I have knowledge of the facts, statements, and matters herein contained and the log of the
above-described well as filed and that the same are true and correct. So help me God.

(Signature) *Chas H Keevert*
Wilson Rd., Route 1, Hutchinson, Kansas
(Address)

SUBSCRIBED AND SWORN to before me this 6th day of December, 19 65

My commission expires November 29, 1966.

Vivian F. Yinger
Vivian F. Yinger Notary Public.



ARNOLD "A" NO. 2 WELL

LOCATION: NW/4 NW/4 NW/4
Section 23-138-21W
Trego County, Kansas

SPUDDED: 8-26-63
COMPLETED: 9- 5-63

OWNER, OPERATOR
and CONTRACTOR: Birmingham-Bartlett Drilling Co.
300 Kaufman Building
Wichita 2, Kansas

SURFACE CASING: 8-5/8" casing cemented at 244'
with 165 sacks cement.

OIL STRING: 5-1/2" OD 15.50# J-55-R-2
cemented at 3972' with
150 sacks cement and 3% gel.

LOG

(Figures indicate bottom of formation)

0 -	30	Surface clay
	70	Shale and shells
	243	Shale
	1055	Shale and shells
	1375	Sand
	1475	Shale and shells
	1639	Red bed
	1680	Anhydrite
	2235	Shale and shells
	3425	Shale and lime
	3483	Lime
	3595	Lime and shale
	3870	Lime
	3884	Conglomerate
	3905	Cherty lime
	3915	Lime
	3943	Lime and chert
	3973	Lime and shale
	3973	Rotary total depth

RECEIVED
STATE CORPORATION COMMISSION

NOV 4 1965

CONSERVATION DIVISION
Wichita, Kansas

The undersigned, Richard Hindery, one of the partners of Birmingham-Bartlett Drilling Co., hereby certifies that the above is a true and correct log of the ARNOLD "A" NO. 2 WELL as shown in the daily drilling reports.

BIRMINGHAM-BARTLETT DRILLING CO.

By Richard Hindery
Richard Hindery, Partner

Subscribed and sworn to before me
this 10th day of September, 1963.

Beverly Larson
Beverly Larson, Notary Public
My commission expires October 2, 1966.