

15-195-21097-00-00


STATE OF KANSAS  
STATE CORPORATION COMMISSION

WELL PLUGGING RECORD

Give All Information Completely  
Make Required Affidavit  
Mail or Deliver Report to  
Conservation Division  
State Corporation Comm.  
245 North Water  
Wichita, KS 67202

Trego County, Sec. 28 Twp. 13 Rge. 21 E/W  
Location as "NE/CNW $\frac{1}{4}$ SW $\frac{1}{4}$ " or footage from lines  
C NW NW

Lease Owner J. B. Collins  
Lease Name Locker Well No. 3  
Office Address 1007 Cody Ave. Suite A, Hays, KS 67601  
Character of Well (Completed as Oil, Gas or Dry Hole)  
Dry Hole

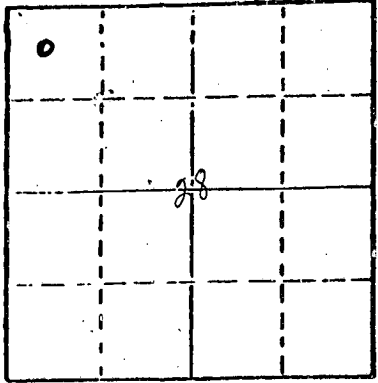

Locate well correctly on above  
Section Plot

Date Well completed 10-26 1982  
Application for plugging filed 10-26 1982  
Application for plugging approved 10-26 1982  
Plugging commenced 10-26 1982  
Plugging completed 10-26 1982  
Reason for abandonment of well or producing formation

If a producing well is abandoned, date of last production 19

Was permission obtained from the Conservation Division or its agents before plugging was commenced? Yes

Name of Conservation Agent who supervised plugging of this well Carl Goodrow  
Producing formation Depth to top Bottom Total Depth of Well 4145'  
Show depth and thickness of all water, oil and gas formations.

OIL, GAS OR WATER RECORDS

CASING RECORD

FORMATION	CONTENT	FROM	TO	SIZE	PUT IN	PULLED OUT
				8 5/8"	207'	-0-

Describe in detail the manner in which the well was plugged, indicating where the mud fluid was placed and the method or methods used in introducing it into the hold. If cement or other plugs were used, state the character of same and depth placed, from feet to feet for each plug set.

- 1st plug was set at 1780' with 10 sacks cement
- 2nd plug was set at 925' with 80 sacks cement
- 3rd plug was set at 250' with 40 sacks cement
- 4th plug was set at 40' with 10 sacks cement

(If additional description is necessary, use BACK of this sheet)

Name of Plugging Contractor Dreiling Oil, Inc., Victoria, KS 67671


STATE OF KANSAS COUNTY OF ELLIS, ss.  
John B. Collins (employee of owner) or (owner or operator)  
of the above-described well, being first duly sworn on oath, says: That I have knowledge of the facts, statements, and matters herein contained and the log of the above-described well as filed and that the same are true and correct. So help me God.

(Signature) John B. Collins  
1007 Cody - Suite A, Hays, Kansas 67601  
(Address)

SUBSCRIBED AND SWORN TO before me this 10th day of November, 1982

Gloria J. Brown  
Notary Public.

My commission expires 7-15-84

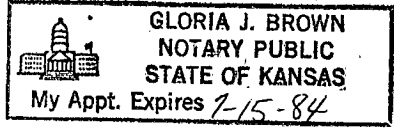

RECEIVED  
STATE CORPORATION COMMISSION

NOV 12 1982

CONSERVATION DIVISION  
Wichita, Kansas