

15-195-20465-00-00


STATE OF KANSAS
STATE CORPORATION COMMISSION

WELL PLUGGING RECORD

Give All Information Completely
Make Required Affidavit
Mail or Deliver Report to
Conservation Division
State Corporation Comm.
245 North Water
Wichita, KS 67202

Trego County. Sec. 10 Twp. 13S Rge. 21 E/W
Location as "NE/CNW $\frac{1}{4}$ SW $\frac{1}{4}$ " or footage from lines
30' NE of SW NW SE

Lease Owner Euwer Petroleum Company
Lease Name Cox Well No. 1
Office Address 110 N. Market - Suite 206, Wichita, Ks. 67202
Character of Well (Completed as Oil, Gas or Dry Hole)
Dry Hole

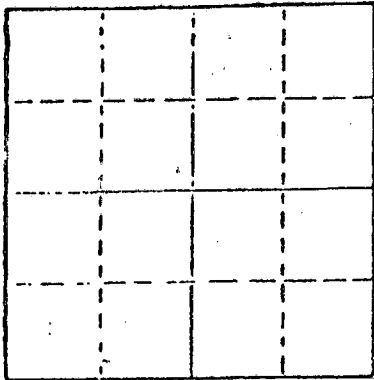

Locate well correctly on above
Section Plat

Date Well completed 4-25-78 19
Application for plugging filed 4-25-78 19
Application for plugging approved 4-25-78 19
Plugging commenced 4-25-78 19
Plugging completed 4-25-78 19
Reason for abandonment of well or producing formation
commercial quantities of oil not found
If a producing well is abandoned, date of last production 19

Was permission obtained from the Conservation Division or
its agents before plugging was commenced? Yes

Name of Conservation Agent who supervised plugging of this well Gilbert Balthazor, Palco, Ks.
Producing formation _____ Depth to top _____ Bottom _____ Total Depth of Well 3970'
Show depth and thickness of all water, oil and gas formations.

OIL, GAS OR WATER RECORDS

CASING RECORD

FORMATION	CONTENT	FROM	TO	SIZE	PUT IN	PULLED OUT
				8-5/8"	268'	

Describe in detail the manner in which the well was plugged, indicating where the mud fluid
was placed and the method or methods used in introducing it into the hold. If cement or other
plugs were used, state the character of same and depth placed, from _____ feet to
_____ feet for each plug set.

Plugged @ 650' with 70 sx.
240' with 20 sx.
40' with 10 sx.

RECEIVED
STATE CORPORATION COMMISSION
MAY 03 1978
05-03-1978
CONSERVATION DIVISION
Wichita, Kansas

(If additional description is necessary, use BACK of this sheet).

Name of Plugging Contractor Rains & Williamson Oil Co., Inc.

STATE OF KANSAS COUNTY OF SEDGWICK, ss.
Wilson Rains, President (employee of owner) or (owner or operator)
of the above-described well, being first duly sworn on oath, says: That I have knowledge of
the facts, statements, and matters herein contained and the log of the above-described well
as filed and that the same are true and correct. So help me God.

(Signature) Wilson Rains Wilson Rains
435 Page Ct., 220 W. Douglas, Wichita, Ks. 67202
(Address)

SUBSCRIBED AND SWORN TO before me this 26th day of April, 1978



My commission expires October 4, 1979
Juanita M. Green
Notary Public.

15-~~195~~¹⁹⁵-20465-00-00

DRILLER'S LOG

COMPANY: Euwer Petroleum Company

SEC. 10 T. 13S R. 21W

WELL NAME: Cox #1

LOC. 30' NE of SW NW SE

COUNTY: Trego County, Kansas

RIG NO. 7

TOTAL DEPTH 3970'

ELEVATION

COMMENCED: 4-15-78

COMPLETED: 4-25-78

CONTRACTOR: Rains & Williamson Oil Co., Inc.

CASING RECORD:

SURFACE: 8-5/8" @ 268' with 190 sx. common, 2% gel, 3% cc.

PRODUCTION: D & A

LOG

(Figures Indicate Bottom of Formations)

Sand and Clay	75
Shale	383
Shale and Sand	1383
Sandy Shale	1535
Anhydrite	1576
Shale	2330
Shale and Lime	3200
Lime	3970
<u>Rotary Total Depth</u>	<u>3970</u>

RECEIVED
STATE CORPORATION COMMISSION
MAY 03 1978
05-03-1978
CONSERVATION DIVISION
Wichita, Kansas

STATE OF KANSAS)


COUNTY OF SEDGWICK)

SS:

I, Wilson Rains, President of Rains & Williamson Oil Co., Inc.

upon oath state that the above and foregoing is a true and correct copy of the log of the
Cox #1 well.

Wilson Rains
Wilson Rains

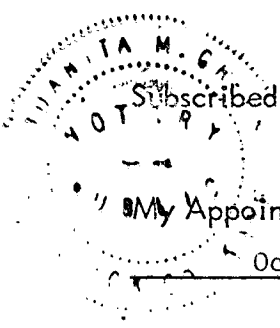

Subscribed and sworn to before me this 26th day of April, 1978.

My Appointment Expires:
October 4, 1979

Juanita M. Green
Juanita M. Green - Notary Public