

195  
15-~~51~~-20460-00-00  
RECEIVED  
STATE CORPORATION COMMISSION

FEB 10 1982  
02-10-1982  
CONSERVATION DIVISION  
Wichita, Kansas


FORM CP-4

STATE OF KANSAS  
STATE CORPORATION COMMISSION

WELL PLUGGING RECORD

Give All Information Completely  
Make Required Affidavit  
Mail or Deliver Report to  
Conservation Division  
State Corporation Comm.  
245 North Water  
Wichita, KS 67202

Trego County, Sec. 10 Twp. 13S Rge. 21W E/W  
Location as "NE/CNW $\frac{1}{4}$ SW $\frac{1}{4}$ " or footage from lines  
SW NW NW  
Lease Owner Frontier Oil Company  
Lease Name Cox Well No. 1  
Office Address 1720 Ks State Bank Bldg., Wichita, Ks 67202  
Character of Well (Completed as Oil, Gas or Dry Hole)  
Possible future disposal well  
Date Well completed April 11, 1978  
Application for plugging filed January 8, 1982  
Application for plugging approved January 18, 1982  
Plugging commenced January 19, 1982  
Plugging completed January 19, 1982  
Reason for abandonment of well or producing formation

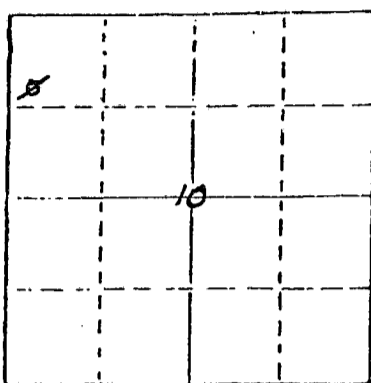

Locate well correctly on above Section Plat

D&A  
If a producing well is abandoned, date of last production  
n/a 19  
Was permission obtained from the Conservation Division or  
its agents before plugging was commenced? Yes

Name of Conservation Agent who supervised plugging of this well Gil Balthazor / Dennis Hamel  
Producing formation n/a Depth to top n/a Bottom n/a Total Depth of Well 3952  
Show depth and thickness of all water, oil and gas formations.

OIL, GAS OR WATER RECORDS

CASING RECORD

FORMATION	CONTENT	FROM	TO	SIZE	PUT IN	PULLED OUT
				8 5/8"	273'	-0-

Describe in detail the manner in which the well was plugged, indicating where the mud fluid was placed and the method or methods used in introducing it into the hold. If cement or other plugs were used, state the character of same and depth placed, from feet to feet for each plug set.

Mud & Gel to 274'  
Plug @ 273' w/140 sx cmt  
23 sx + 4 sx + 3 sx hulls to surface

(If additional description is necessary, use BACK of this sheet)

Name of Plugging Contractor Allied Cementing Co., Inc.

STATE OF Kansas COUNTY OF Sedgwick, ss.  
George A. Angle (owner or operator)  
of the above-described well, being first duly sworn on oath, says: That I have knowledge of the facts, statements, and matters herein contained and the log of the above-described well as filed and that the same are true and correct. So help me God.

(Signature) George A. Angle  
1720 Kansas St Bank Bldg., Wichita, Ks 67202  
(Address)

SUBSCRIBED AND SWORN TO before me this 19th day of January, 1982

Jean Stocks  
Notary Public.

My commission expires 5-14-85



DRILLER'S LOG

195  
15-~~051~~-20460-00-00

COMPANY: Euwer Petroleum Company

SEC. 10 T. 13S R. 21W

WELL NAME: Cox #1

LOC. 30' NE of SW NW SE

COUNTY: Trego County, Kansas

RIG NO. 7

TOTAL DEPTH 3970'

ELEVATION

COMMENCED: 4-15-78

COMPLETED: 4-25-78

CONTRACTOR: Rains & Williamson Oil Co., Inc.

CASING RECORD:

SURFACE: 8-5/8" @ 268' with 190 sx. common, 2% gel, 3% cc.

PRODUCTION: D & A

LOG

(Figures Indicate Bottom of Formations)

Sand and Clay	75
Shale	383
Shale and Sand	1383
Sandy Shale	1535
Anhydrite	1576
Shale	2330
Shale and Lime	3200
Lime	3970
<u>Rotary Total Depth</u>	<u>3970</u>

RECEIVED  
STATE CORPORATION COMMISSION  
MAY 03 1978  
05-03-1978  
CONSERVATION DIVISION  
Wichita, Kansas

STATE OF KANSAS )

COUNTY OF SEDGWICK )

SS:

I, Wilson Rains, President of Rains & Williamson Oil Co., Inc.

upon oath state that the above and foregoing is a true and correct copy of the log of the Cox #1 well.

Wilson Rains  
Wilson Rains

Subscribed and sworn to before me this 26th day of April, 1978.

My Appointment Expires:

October 4, 1979

Juanita M. Green  
Juanita M. Green - Notary Public

