


15-~~195~~-20707 00-00

STATE OF KANSAS
STATE CORPORATION COMMISSION

WELL PLUGGING RECORD

Give All Information Completely
Make Required Affidavit
Mail or Deliver Report to
Conservation Division
State Corporation Comm.
245 North Water
Wichita, KS 67202

Trego County, Sec. 19 Twp. 13S Rge. 21W E/W
Location as "NE/CNW $\frac{1}{4}$ SW $\frac{1}{4}$ " or footage from lines
SW SW NE
Lease Owner Petroventures, Inc.
Lease Name Honas Well No. 1
Office Address 730-17th St., Denver, Colorado 80202
Character of Well (Completed as Oil, Gas or Dry Hole)
Dry Hole

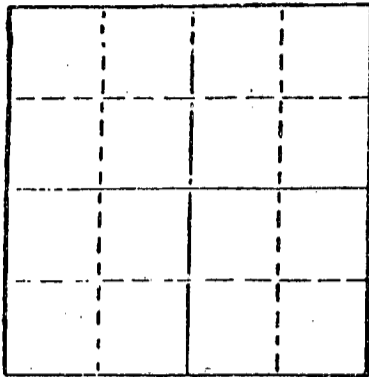

Locate well correctly on above
Section Plot

Date Well completed September 28, 1980
Application for plugging filed September 28, 1980
Application for plugging approved September 28, 1980
Plugging commenced September 28, 1980
Plugging completed September 28, 1980
Reason for abandonment of well or producing formation
Dry Hole

If a producing well is abandoned, date of last production
19

Was permission obtained from the Conservation Division or
its agents before plugging was commenced? Yes

Name of Conservation Agent who supervised plugging of this well Marion Schmidt
Producing formation _____ Depth to top _____ Bottom _____ Total Depth of Well 4,100
Show depth and thickness of all water, oil and gas formations.

OIL, GAS OR WATER RECORDS

CASING RECORD

FORMATION	CONTENT	FROM	TO	SIZE	PUT IN	PULLED OUT
				8-5/8"	276'	

Describe in detail the manner in which the well was plugged, indicating where the mud fluid
was placed and the method or methods used in introducing it into the hold. If cement or other
plugs were used, state the character of same and depth placed, from _____ feet to
_____ feet for each plug set.

Mud to 700', 60 sx cement

Mud to 260', 30 sx cement

Mud to 40', plug, 1/4 sk hulls,
10 sx cement

5=sx in rathole

RECEIVED
OCT 04 1980
STATE CORPORATION COMMISSION
CONSERVATION DIVISION
Wichita, Kansas ss.

(If additional description is necessary, use BACK of this sheet)

Name of Plugging Contractor _____


STATE OF Kansas COUNTY OF Sedgwick
Donald E. Hunt (employee of owner) or (~~owner or operator~~)

of the above-described well, being first duly sworn on oath, says: That I have knowledge of
the facts, statements, and matters herein contained and the log of the above-described well
as filed and that the same are true and correct. So help me God.

(Signature) Donald E. Hunt
Suite 250, 200 West Douglas, Wichita, Kansas
(Address)

SWORN TO before me this 30th day of September, 1980

Kathleen L. Greger
Kathleen L. Greger Notary Public.

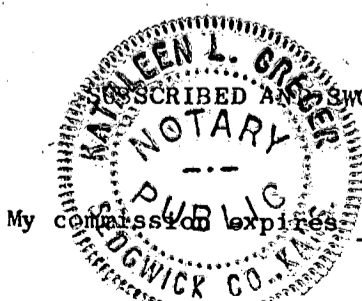

Janaury 4, 1981

