

STATE OF KANSAS  
STATE CORPORATION COMMISSION  
200 Colorado Derby Bldg.  
Wichita, Kansas 67202


Form CP-4  
Rev. 12-15-80

WELL PLUGGING RECORD

Give All Information Completely  
Make Required Affidavit

COUNTY Trego SEC. 5 TWP. 13S RGE. 21 E/W  
Location as in quarters or footage from lines:

#330' from South line and 1650' from East line of -SE/4-

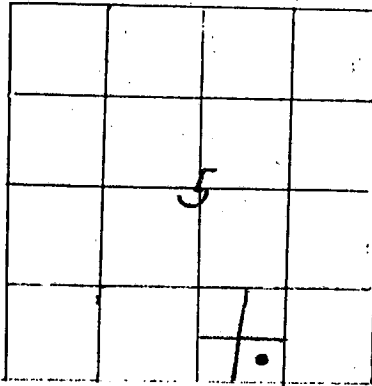

Locate Well  
correctly on above  
Section Platt.

\*Lease Owner Zenith Petroleum Corporation Kansas Partnership No. 1  
Lease Name Harold Deutscher Well No. 2  
Office Address 7600 W. Tidwell, Ste. 502, Houston, TX 77040  
Character of Well (Completed as Oil, Gas or Dry Hole): Dry Hole  
Date Well Completed \_\_\_\_\_  
Application for plugging filed June 2, 1982 \*\*  
Plugging commenced 5/4/82  
Plugging completed 5/4/82  
Reason for abandonment of well or producing formation \_\_\_\_\_

Drilled as a dry hole  
Was permission obtained from the Conservation Division or it's  
Agent's before plugging was commenced? Yes

Name of Conservation Agent who supervised plugging of this well Carl Goodrow  
Producing formation \_\_\_\_\_ Depth to top \_\_\_\_\_ bottom \_\_\_\_\_ T.D. 4050

Show depth and thickness of all water, oil and gas formations.

OIL, GAS OR WATER RECORDS

Casing Record

Formation	Content	From	To	Size	Put in	Pulled Out
	NONE			8-5/8"	347'	NONE

Describe in detail the manner in which the well was plugged, indicating where the mud fluid was placed and the method or methods used in introducing it into the hold. If cement or other plugs were used, state the character of same and depth placed, from \_\_\_\_\_ feet to \_\_\_\_\_ feet for each plug set.

Set plug #1 in 7-7/8" openhole using 70 sxs 50-50 Pozmix, 4% gel, 3% CaCl<sub>2</sub> cement from 465' to 750'  
Set plug #2 in 8-5/8" casing using 40 sxs 50-50 Pozmix, 4% gel, 3% CaCl<sub>2</sub> cement from 200' to 350'  
Set plug #3 in 8-5/8" casing using 10 sxs 50-50 Pozmix, 4% gel, 3% CaCl<sub>2</sub> cement from 15' to 40'

Cemented rat hole with 10 sxs Pozmix

RECEIVED  
STATE CORPORATION COMMISSION

JUN 14 1982

(If additional description is necessary, use BACK of this sheet)

Name of Plugging Contractor Halliburton Services CONSERVATION DIVISION  
410 Union Center Bldg. 410 Union Center Bldg., Wichita, KS 67202 Wichita Kansas

STATE OF Texas COUNTY OF Harris, ss.  
E. B. Rogers (employee or owner) for (owner) operator of the  
above-described well, being first duly sworn on oath, says: That I have knowledge of the  
facts, statements, and matters herein contained and the log of the above-described well as  
filed and that the same are true and correct. So help me God.

(Signature) E. B. Rogers

7600 W. Tidwell, Ste. 502  
Houston, TX Address: 77040

SUBSCRIBED AND SWORN TO before me 1983 3rd day of June

RECEIVED  
STATE CORPORATION COMMISSION  
AUG 1 1983  
CONSERVATION DIVISION  
Wichita, Kansas

Kathleen Ann Chaley  
Notary Public

My Commission expires: April 10, 1984

\* Notice of Intention to drill filed in the name of Zenith Petroleum Corporation under  
the lease name of H. Deutscher.

\*\* Verbal permission granted to plug well by Mr. Carl Goodrow on 5/4/82.