

15-051-00073-00-00


STATE OF KANSAS  
STATE CORPORATION COMMISSION

WELL PLUGGING RECORD

Give All Information Completely  
Make Required Affidavit  
Mail or Deliver Report to:  
Conservation Division  
State Corporation Commission  
800 Biting Building  
Wichita, Kansas

Ellis County, Sec. 31 Twp. 13S Rge. 20W ~~(E)XXXXXX~~

Location as "NE/CNW%SW%" or footage from lines NE NE NE  
Lease Owner Imperial Drilling Company, Inc.  
Lease Name Kroeger Well No. 1  
Office Address 903 Union Nat'l. Bank Bldg., Wichita 2, Kans.  
Character of Well (completed as Oil, Gas or Dry Hole) Dry Hole  
Date well completed October 27 19 52  
Application for plugging filed " " 19 " "  
Application for plugging approved " " 19 " "  
Plugging commenced " " 19 " "  
Plugging completed " " 19 " "  
Reason for abandonment of well or producing formation Oil in commercial quantities not found  
If a producing well is abandoned, date of last production - - - 19 - - -  
Was permission obtained from the Conservation Division or its agents before plugging was commenced? ~~XXXXX~~ Yes

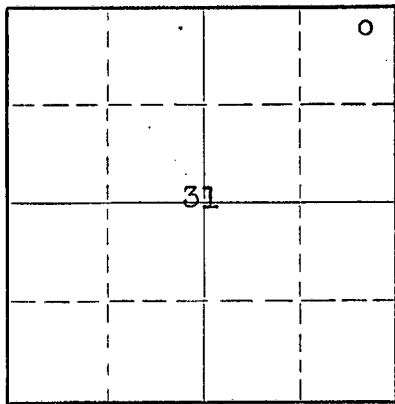

Locate well correctly on above Section Plat

Name of Conservation Agent who supervised plugging of this well Eldon Petty, Hays, Kansas  
Producing formation - - - - - Depth to top - - - - - Bottom - - - - - Total Depth of Well 3988' Feet  
Show depth and thickness of all water, oil and gas formations.

OIL, GAS OR WATER RECORDS

CASING RECORD

FORMATION	CONTENT	FROM	TO	SIZE	PUT IN	PULLED OUT
				8 5/8"	190'	None

Describe in detail the manner in which the well was plugged, indicating where the mud fluid was placed and the method or methods used in introducing it into the hole. If cement or other plugs were used, state the character of same and depth placed, from \_\_\_\_\_ feet to \_\_\_\_\_ feet for each plug set.

Filled hole with heavy mud to 180 feet.  
Set #1 Plug with 15 sks. cement. Set #2  
Plug 40 feet down from top of hole with  
10 sks. cement to top of hole.

RECEIVED  
NOV 4 1952  
CONSERVATION DIVISION  
Wichita, Kansas


(If additional description is necessary, use BACK of this sheet)  
Name of Plugging Contractor Imperial Drilling Company, Inc.  
Address 903 Union National Bank Bldg., Wichita 2, Kansas

STATE OF KANSAS, COUNTY OF SEDGWICK, ss.  
Raymond L. Bacon (employee of owner) ~~or owner or operator~~ of the above-described well, being first duly sworn on oath, says: That I have knowledge of the facts, statements, and matters herein contained and the log of the above-described well as filed and that the same are true and correct. So help me God. IMPERIAL DRILLING COMPANY, INC.  
(Signature) Raymond L. Bacon Vice-Pres.  
Wichita, Kansas (Address)

SUBSCRIBED AND SWORN TO before me this 3rd day of November 19 52

My commission expires January 4, 1954

Marguerite Tuttle  
Notary Public.

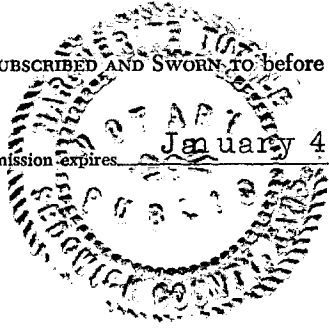

24-2675-5 2-52-20M

PLUGGING  
FILE SEC 31 13 R 204  
BOOK PAGE 55 LINE 20

15-051-00073-00-00

DRILLER'S LOG

Imperial Drilling Company, Inc.  
903 Union National Bank Building  
Wichita 2, Kansas

Kroeger No. 1  
NE NE NE  
Sec. 31-138-20W  
Ellis County, Kansas.

Total Depth: 3988'

Elevation: 2284 K.B.

Commenced: 10-19-52 Completed: 10-27-52 Production: D & A

Contractor: Imperial Drilling Company, Inc.  
903 Union National Bank Building  
Wichita, Kansas

Casing Record: Set 190' of 8 5/8" surface pipe w/125 sacks cement.

Figures indicate bottom of formations:

Surface Clay & Rock	100'		
Surface Clay & Shells	130'		
Shale & Shells	350'	Elevation	2284 K.B.
Shale & Sand	675'	Anhydrite	1611' (-673)
Blue Clay & Shells	1075'	Heetner	3537' (-1255)
Dakota Sand	1325'	Lansing	3579' (-1295)
Shale, Shells & Red Rock	1430'	base of K.C.	3519' (-1535)
Shale & Shells	1611'	Penn. Conglomerate	3874' (-1590)
Anhydrite	1655'	Arbuckle	3938' (-1654)
Shale & Shells	1730'		
Shale & Lime	2085'	Total Depth (Rotary)	3988' (-1704)
Lime & Shale	3550'		
Lime	3915'		
Lime & Chert	3935'		
Lime	3945'		
Arbuckle Lime	3988'		
Total Depth	3988'		

TOPS

11-04-1952

We hereby certify this to be a correct and accurate log of the above described well as shown on the daily drilling reports.

IMPERIAL DRILLING COMPANY, INC.

BY: Raymond J. Bacon  
Vice-President

Subscribed and sworn to before me this 31st day of October, 1952.

Marguerite Little  
Notary Public

My commission expires:  
1-4-54

PLUGGING  
FILE SEC 31 T 13 S 20 W  
BOOK PAGE 55 LINE 20