

15-195-20726-00-00

STATE OF KANSAS  
STATE CORPORATION COMMISSION

WELL PLUGGING RECORD

Give All Information Completely  
Make Required Affidavit  
Mail or Deliver Report to  
Conservation Division  
State Corporation Comm.  
245 North Water  
Wichita, KS 67202

Trego County, Sec. 7 Twp. 13S Rge. 21W Exx  
Location as "NE/CNW $\frac{1}{4}$ SW $\frac{1}{4}$ " or footage from lines  
SE SW SW

Lease Owner Gear Petroleum Company, Inc.  
Lease Name Herl Well No. 5  
Office Address 300 Sutton Place, Wichita 67202  
Character of Well (Completed as Oil, Gas or Dry Hole)


Dry Hole

Date Well completed 11/25/80 19  
Application for plugging filed 11/25/80 19  
Application for plugging approved 11/25/80 19  
Plugging commenced 11/25/80 19  
Plugging completed 11/25/80 8:30 a.m. 19  
Reason for abandonment of well or producing formation

If a producing well is abandoned, date of last production 19

Was permission obtained from the Conservation Division or its agents before plugging was commenced? Yes

Name of Conservation Agent who supervised plugging of this well Gil Balthazor  
Producing formation Depth to top Bottom Total Depth of Well  
Show depth and thickness of all water, oil and gas formations. RTD 4008'

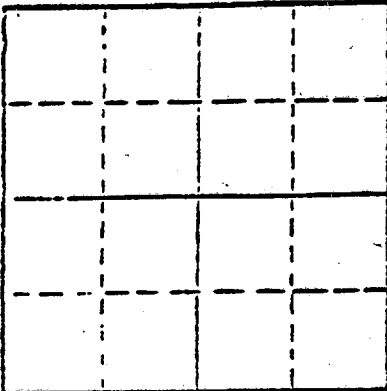

Locate well correctly on above Section Plot

OIL, GAS OR WATER RECORDS

CASING RECORD

| FORMATION | CONTENT | FROM | TO   | SIZE   | PUT IN | PULLED OUT |
|-----------|---------|------|------|--------|--------|------------|
|           | Surface | 0    | 249' | 8-5/8" | yes    | no         |
|           |         |      |      |        |        |            |
|           |         |      |      |        |        |            |

Describe in detail the manner in which the well was plugged, indicating where the mud flu. was placed and the method or methods used in introducing it into the hold. If cement or other plugs were used, state the character of same and depth placed, from feet to feet for each plug set.

1st plug @ 840' with 60 sx  
2nd plug @ 240' with 30 sx  
3rd plug @ 40' with 10 sx  
5 sacks in rathole  
Job complete @ 8:30 a.m. 11/25/80

(If additional description is necessary, use BACK of this sheet)

Name of Plugging Contractor Slawson Drilling Company, Inc. CONSERVATION DIVISION  
15 1980 12-15-80

STATE OF Kansas COUNTY OF Sedgwick, ss.  
James C. Remsberg, Slawson Drilling Co., Inc. (employee of owner) or (owner or operator) of the above-described well, being first duly sworn on oath, says: That I have knowledge of the facts, statements, and matters herein contained and the log of the above-described well as filed and that the same are true and correct. So help me God.

(Signature)

James C. Remsberg  
James C. Remsberg  
207 Douglas Building, Wichita 67202  
(Address)

SUBSCRIBED AND SWORN TO before me this 11 day of December, 1980

Mary Lou Taylor  
Mary Lou Taylor Notary Public.

My commission expires January 17, 1981



15-195

DRILLERS LOG

OPERATOR: Gear Petroleum Company, Inc.  
 300 Sutton place  
 Wichita, Kansas 67202

WELL NAME: Herl #5  
 SE SW SW Sec.7-13S-21W  
 Trego County, Kansas

CONTRACTOR: Slawson Drilling Company, Inc.  
 200 Douglas Building  
 Wichita, Kansas 67202

COMMENCED: 11/17/80

COMPLETED: 11/25/80

RTD: 4008'

SURFACE CASING: 8-5/8" set at 249' with 170 sx cement

0' to 251' Clay, Lime, Shale, Pyrite @ 214'  
 251' to 1138' Shale  
 1138' to 1425' Sand  
 1425' to 1686' Shale  
 1686' to 1724' Anhydrite  
 1724' to 1875' Shale  
 1875' to 2060' Shale & Shells  
 2060' to 3245' Shale  
 3245' to 3590' Shale & Lime  
 3590' to 3960' Lime & Shale  
 3960' to 4008' Lime  
 RTD 4008'

STATE OF KANSAS

COUNTY OF SEDGWICK

I, James C. Remsberg, of the Slawson Drilling Company, Inc. hereby state the above is an accurate copy of the Herl #5 log for Gear Petroleum Co., Inc.

*James C. Remsberg*  
 James C. Remsberg

Subscribed and sworn to me this 11th day of December, 1980

*Mary Lou Taylor*  
 Mary Lou Taylor Notary

My commission expires January 17, 1981

