

15-195-20393-00-00


STATE OF KANSAS
STATE CORPORATION COMMISSION

WELL PLUGGING RECORD

Give All Information Completely
Make Required Affidavit
Mail or Deliver Report to
Conservation Division
State Corporation Comm.
245 North Water
Wichita, KS 67202

Trego County, Sec. 7 Twp. 13 Rge. 21 ~~EW~~
Location as "NE/CNW $\frac{1}{4}$ SW $\frac{1}{4}$ " or footage from lines _____

NW NE NE
Lease Owner Dreiling Oil, Inc.
Lease Name Glass Well No. 3
Office Address Rt. #1, Victoria, KS 67671
Character of Well (Completed as Oil, Gas or Dry Hole) _____

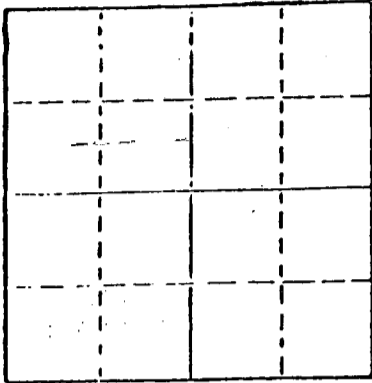

Dry Hole
Date Well completed 1-8 1977
Application for plugging filed 1-8 1977
Application for plugging approved 1-8 1977
Plugging commenced 1-8 1977
Plugging completed 1-8 1977
Reason for abandonment of well or producing formation _____

Dry Hole
If a producing well is abandoned, date of last production 19 _____

Was permission obtained from the Conservation Division or its agents before plugging was commenced? yes _____

Name of Conservation Agent who supervised plugging of this well Gilbert Balthazor
Producing formation _____ Depth to top _____ Bottom _____ Total Depth of Well 4013
Show depth and thickness of all water, oil and gas formations.

OIL, GAS OR WATER RECORDS

CASING RECORD

FORMATION	CONTENT	FROM	TO	SIZE	PUT IN	PULLED OUT

Describe in detail the manner in which the well was plugged, indicating where the mud fluid was placed and the method or methods used in introducing it into the hold. If cement or other plugs were used, state the character of same and depth placed, from _____ feet to _____ feet for each plug set.

- 1st plug was set @ 1100' w/70 sacks cement
- 2nd plug was set @ 200' w/20 sacks cement
- 3rd plug was set @ 40' w/10 sacks cement

RECEIVED
STATE CORPORATION COMMISSION

JAN 17 1977 01-17-77

CONSERVATION DIVISION
Wichita, Kansas

(If additional description is necessary, use BACK of this sheet)

Name of Plugging Contractor Dreiling Oil, Inc.

STATE OF KANSAS COUNTY OF ELLIS, ss.
I, Joseph A. Hess, Sec. Treas. of Dring Contractor (employee of owner) or (owner or operator) of the above-described well, being first duly sworn on oath, says: That I have knowledge of the facts, statements, and matters herein contained and the log of the above-described well as filed and that the same are true and correct. So help me God.

(Signature) Joseph A. Hess
JOSEPH A. HESS, Hays, KS 67601
(Address)

SUBSCRIBED AND SWORN TO before me this 13th day of January, 19 77

CECILIA BASGALL
NOTARY PUBLIC

Cecilia Basgall
Cecilia Basgall Notary Public.

My commission expires November 17, 1980

