


15-195-21016-00-00

WELL PLUGGING RECORD

Give All Information Completely  
 Make Required Affidavit

COUNTY Trego SEC. 20 TWP. 13S RGE. 21W E/W  
 Location as in quarters or footage from lines:  
 NW SE NW

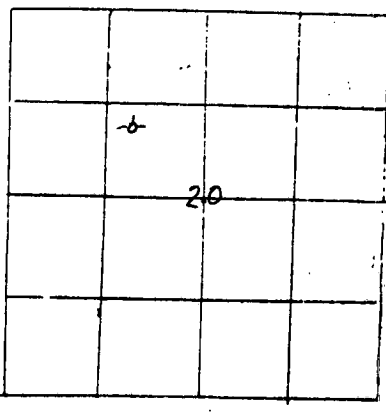

Locate Well  
 correctly on above  
 Section Platt.

Lease Owner DONALD C. SLAWSON  
 Lease Name DENNING 'C' Well No. 1  
 Office Address 200 Douglas Building Wichita, Kansas 67202  
 Character of Well (Completed as Oil, Gas or Dry Hole): Dry Hole  
 Date Well Completed June 16, 1982  
 Application for plugging filed Yes  
 Plugging commenced June 16, 1982  
 Plugging completed June 16, 1982  
 Reason for abandonment of well or producing formation Dry Hole

Was permission obtained from the Conservation Division or it's  
 Agent's before plugging was commenced? Yes

Name of Conservation Agent who supervised plugging of this well Dennis Hamel

Producing formation \_\_\_\_\_ Depth to top \_\_\_\_\_ bottom \_\_\_\_\_ T.D. 4050'  
 Show depth and thickness of all water, oil and gas formations.

OIL, GAS OR WATER RECORDS Casing Record

Formation	Content	From	To	Size	Put in	Pulled Out
		surface	287'	8 5/8"		

Describe in detail the manner in which the well was plugged, indicating where the mud  
 fluid was placed and the method or methods used in introducing it into the hold. If cement  
 or other plugs were used, state the character of same and depth placed, from \_\_\_\_\_ feet  
 to \_\_\_\_\_ feet for each plug set.


1st plug @ 900' w/70 sx  
 2nd plug @ 300' w/40 sx  
 Bridge @ 40' w/10 sx  
 10 sx in Rat Hole

(If additional description is necessary, use BACK of this sheet)

Name of Plugging Contractor Halliburton Services  
Box 579 Great Bend, Kansas 67530

STATE OF KANSAS COUNTY OF SEDGWICK, ss.  
William R. Horigan (employee of owner) or (owner or operator) of the  
 above-described well, being first duly sworn on oath, says: That I have knowledge of the  
 facts, statements, and matters herein contained and the log of the above-described well as  
 filed and that the same are true and correct. So help me God.

(Signature) William R. Horigan  
William R. Horigan 200 Douglas Building  
 (Address) Wichita, KS 67202

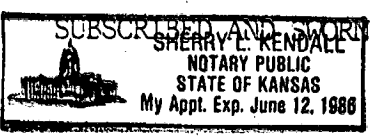

TO before me this 29th day of November, 19 82

Sherry L. Kendall  
 Sherry L. Kendall Notary Public.

My Commission expires: 06/12/86

RECEIVED  
 STATE CORPORATION COMMISSION

DEC 10 1982  
 17-10-82  
 CONSERVATION DIVISION  
 Wichita, Kansas