

15-195-00080-00-00

STATE OF KANSAS
STATE CORPORATION COMMISSION

WELL PLUGGING RECORD

Give All Information Completely
Make Required Affidavit
Mail or Deliver Report to:
Conservation Division
State Corporation Commission
800 Bittling Building
Wichita, Kansas

Trego County, Sec. 20 Twp. 13S Rge. 21 (E) W (W)

Location as "NE/CNW/SW" or footage from lines Gen. NW/4 SW/4 NW/4

Lease Owner Amerada Petroleum Corp.

Lease Name J. J. Denning Well No. 1

Office Address 614 Orpheum Bldg.

Character of Well (completed as Oil, Gas or Dry Hole) Dry Hole

Date well completed April 18 19 53

Application for plugging filed April 20 19 53

Application for plugging approved April 18 (Verbally) 19 53


Plugging commenced April 18 19 53

Plugging completed April 18 19 53

Reason for abandonment of well or producing formation Dry Hole

If a producing well is abandoned, date of last production 19

Was permission obtained from the Conservation Division or its agents before plugging was commenced? Yes

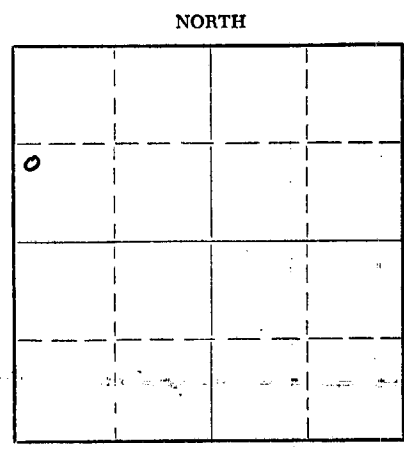

Locate well correctly on above Section Plat

Name of Conservation Agent who supervised plugging of this well Eldon Petty

Producing formation Depth to top Bottom Total Depth of Well Feet

Show depth and thickness of all water, oil and gas formations.

OIL, GAS OR WATER RECORDS

CASING RECORD

FORMATION	CONTENT	FROM	TO	SIZE	PUT IN	PULLED OUT
				8-5/8"	209'	none

Describe in detail the manner in which the well was plugged, indicating where the mud fluid was placed and the method or methods used in introducing it into the hole. If cement or other plugs were used, state the character of same and depth placed, from feet to feet for each plug set.

Filled hole with heavy mud to 180'
Set plug at 180'
Dumped 1/2 sack cottonseed hulls on top of plug
Mixed and dumped 15 sacks cement
Filled hole with heavy mud to 40'
Set plug at 40'
Dumped 1/2 sack cottonseed hulls on top of plug
Mixed and dumped 10 sacks cement filling hole to top of 8-5/8" casing in bottom of cellar.

RECEIVED
CORPORATION COMMISSION
MAY - 5 1953
05-05-53
CONSERVATION DIVISION
Wichita, Kansas

Name of Plugging Contractor Survey Drilling Co., c/o Roy Cook
Address Sunset Motel, Hays, Kansas

STATE OF Kansas, COUNTY OF Sedgwick, ss.
J. J. Stone (employee of owner) or (owner or operator) of the above-described well, being first duly sworn on oath, says: That I have knowledge of the facts, statements, and matters herein contained and the log of the above-described well as filed and that the same are true and correct. So help me God.

(Signature) J. J. Stone
614 Orpheum Bldg., Wichita, Kansas (Address)

SUBSCRIBED AND SWORN TO before me this 4 day of May, 19 53

My commission expires October 4, 1956

24-2675-S 2-52-20M

Notary Public seal and stamp: PLUGGING FILE SEC 23 T 13 R 214 BOOK PAGE 94 LINE 24

15-195-00080-00-00

DRILLER'S LOG

Company: Amerada Petroleum Corporation NW SW NW
 Sec. 20, Twp. 13S, Rge. 21W

Farm: J. J. Denning Well No. 1 County: Trego, Kansas

Total Depth: 4125

Comm: 5-2-53 Comp: 4-18-53

Contractor: Survey Drilling Company

Casing: 8-5/8" - 199' - cemented with 110 sks. Elevation: 2252 Ground
 2260 Derrick Floor

Production: Dry

Figures below indicate bottom of formations

Shale and Sand	0 -	1678
Anhydrite		1720
Shale and Shells		3340
Lime and Shale		3580
Shale and Lime		3615
Lime		3860
Shale and Lime		3950
Cherty Lime		4000
Conglomerate		4078
Dolomite		4125
Total Depth		4125

This is to certify that the above information is, to the best of our knowledge true and correct.

Amerada Petroleum Corporation

By: Charles E. Terry

SUBSCRIBED AND SWORN to before me this 21st day of May, 1953

My commission expires Oct 4th 1956 J. P. Kendrick Notary Public



RECEIVED
 STATE CORPORATION COMMISSION
 MAY 26 1953
 CONSERVATION DIVISION
 Wichita, Kansas

PLUGGING
 FILE SEC 20 T 13 R 21W
 BOOK PAGE 94 LINE 24