


STATE OF KANSAS
STATE CORPORATION COMMISSION

WELL PLUGGING RECORD

Give All Information Completely
Make Required Affidavit
Mail or Deliver Report to
Conservation Division
State Corporation Comm.
245 North Water
Wichita, KS 67202

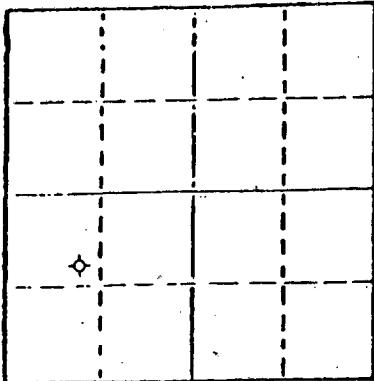

Locate well correctly on above
Section Plat

Trego County. Sec. 22 Twp. 13 Rge. 21
Location as "NE/CNW $\frac{1}{4}$ SW $\frac{1}{4}$ " or footage from lines
1500' FSL, 1200' FWL
Lease Owner Dreilling Ltd. of Colorado
Lease Name Bollig Well No. 1
Office Address 410 - 17th St., Suite 1140, Denver, Colo. 80202
Character of Well (Completed as Oil, Gas or Dry Hole)
Dry Hole

Date Well completed 3-24 1983
Application for plugging filed 3-30 1983
Application for plugging approved 3-24 1983
Plugging commenced 4:30 P.M. 3-24 1983
Plugging completed 7:00 P.M. 3-24 1983
Reason for abandonment of well or producing formation

Non-productive
If a producing well is abandoned, date of last production
None 19

Was permission obtained from the Conservation Division or
its agents before plugging was commenced? yes

Name of Conservation Agent who supervised plugging of this well Ed Schumacher
Producing formation Depth to top Bottom Total Depth of Well 4055'
Show depth and thickness of all water, oil and gas formations.

OIL, GAS OR WATER RECORDS

CASING RECORD

FORMATION	CONTENT	FROM	TO	SIZE	PUT IN	PULLED OUT
Lansing	3' Mud	3670	3745	8-5/8	210	None
Pawnee	6" oil, 3' mud	3996	4013			

Describe in detail the manner in which the well was plugged, indicating where the mud fluid
was placed and the method or methods used in introducing it into the hold. If cement or other
plugs were used, state the character of same and depth placed, from feet to
feet for each plug set. Hole full of heavy mud-pumped cement through
drill pipe as follows:

1st cement plug at 1730' with 20 sacks
2nd cement plug at 944' with 100 sacks
3rd cement plug at 260' with 40 sacks
4th 8-5/8" wood and rubber plug at 40' with solid hull bridge
and 10 sacks, 10 sacks in rathole

180 sacks total 50-50 Pozmix with 6% gel, 3% cc

(If additional description is necessary, use BACK of this sheet)

Name of Plugging Contractor Halliburton

STATE OF Colorado COUNTY OF Denver, ss.
(employee of owner) or (owner or operator)
of the above-described well, being first duly sworn on oath, says: That I have knowledge of
the facts, statements, and matters herein contained and the log of the above-described well
as filed and that the same are true and correct. So help me God.

(Signature)

Ishe Olson

410 - 17th St., Suite 1140, Denver, Co. 80202
(Address)

SUBSCRIBED AND SWORN TO before me this 5th day of April, 1983

Lorraine C. Murphy
Notary Public

My commission expires 9-2-83

RECEIVED
STATE CORPORATION COMMISSION

RECEIVED
STATE CORPORATION COMMISSION APR 7 - 1983

APR 07 1983
04-07-83
CONSERVATION DIVISION
Wichita, Kansas

CONSERVATION DIVISION
Wichita, Kansas