


STATE OF KANSAS
STATE CORPORATION COMMISSION

WELL PLUGGING RECORD

Give All Information Completely
Make Required Affidavit
Mail or Deliver Report to:
Conservation Division
State Corporation Commission
212 No. Market
Wichita, Kansas

Trego County. Sec. 20 Twp. 13S Rge. (E) 21 (W)

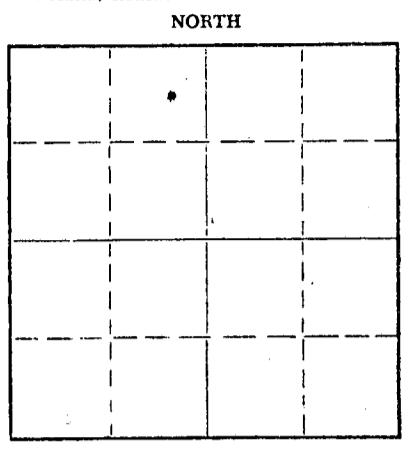

Locate well correctly on above Section Plat

Location as "NE/CNW/SW" or footage from lines NE NW NE
Lease Owner Tilco, et al
Lease Name Egger Well No. 3
Office Address 815 Wichita Plaza, Wichita, Kansas 67202
Character of Well (completed as Oil, Gas or Dry Hole) Dry Hole
Date well completed 1-25 1969
Application for plugging filed 1-25 1969
Application for plugging approved 1-25 1969
Plugging commenced 1-25 1969
Plugging completed 1-25 1969
Reason for abandonment of well or producing formation Dry Hole

If a producing well is abandoned, date of last production 19
Was permission obtained from the Conservation Division or its agents before plugging was commenced? Yes

Name of Conservation Agent who supervised plugging of this well W. L. Nichols
Producing formation _____ Depth to top _____ Bottom _____ Total Depth of Well 4025 Feet
Show depth and thickness of all water, oil and gas formations.

OIL, GAS OR WATER RECORDS

CASING RECORD

| FORMATION | CONTENT | FROM | TO | SIZE | PUT IN | PULLED OUT |
|-----------|---------|------|----|--------|--------|------------|
| | | | | 8 5/8" | 237' | none |
| | | | | | | |
| | | | | | | |
| | | | | | | |
| | | | | | | |
| | | | | | | |

Describe in detail the manner in which the well was plugged, indicating where the mud fluid was placed and the method or methods used in introducing it into the hole. If cement or other plugs were used, state the character of same and depth placed, from _____ feet to _____ feet for each plug set.

Plugged with 100 sacks cement @ 950'
Plugged with 20 sacks cement @ 240'
Plugged with 10 sacks cement @ 40'

RECEIVED
STATE CORPORATION COMMISSION
JAN 28 1969
CONSERVATION DIVISION
Wichita, Kansas

(If additional description is necessary, use BACK of this sheet)


Name of Plugging Contractor Leben Drilling, Inc.
Address Box 486, Great Bend, Kansas

STATE OF KANSAS, COUNTY OF BARTON, ss.
Leslie Kite (employee of owner) or (owner or operator) of the above-described

well, being first duly sworn on oath, says: That I have knowledge of the facts, statements, and matters herein contained and the log of the above-described well as filed and that the same are true and correct. So help me God.

(Signature) Leslie Kite
(Address) _____

SUBSCRIBED AND SWORN to before me this 27th day of January, 1969

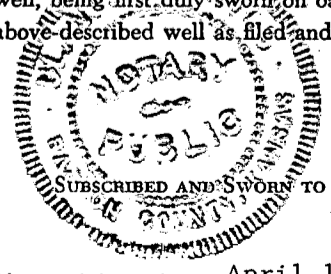

My commission expires April 1, 1971
Ulanda Nichols Notary Public.

DRILLER'S LOG

| | |
|------------|---|
| COMPANY | Tilco, et al |
| CONTRACTOR | LEBEN DRILLING, INC. |
| FARM | EGGER #3 |
| LOCATION | NE NW NE SECTION 20-13S-21W TREGO COUNTY, KANSAS |
| COMMENCED | 1-14-69 |
| COMPLETED | 1-25-69 |

| | | |
|------|------|----------------|
| 0 | 205 | Post Rock Sand |
| 205 | 1615 | Shale |
| 1615 | 1661 | Anhydrite |
| 1661 | 2206 | Shale |
| 2206 | 2772 | Shale, Lime |
| 2772 | 3170 | Lime, Shale |
| 3170 | 3420 | Shale, Lime |
| 3420 | 3890 | Lime |
| 3890 | 3928 | Lime, Chert |
| 3928 | 3971 | Cherty Lime |
| 3971 | 3984 | Lime |
| 3984 | 4025 | Lime, Chert |
| | 4025 | RTD - D. & A. |

RECEIVED
STATE CORPORATION COMMISSION
JAN 28 1969
CONSERVATION DIVISION
Wichita, Kansas

8 5/8" 20# new surface casing set @ 237' cemented with 150 sacks Common cement, 2% cc

I, Leslie Kite, do hereby certify that the above and foregoing is a true and correct copy of the log of the Egger #3 Well, located NE NW NE of Section 20, Township 13 South, Range 21 West, Trego County, Kansas, as reflected by the records of Leben Drilling, Inc.

Leslie Kite

Leslie Kite

STATE OF KANSAS)
)) SS
COUNTY OF BARTON)

Subscribed and sworn to and before me, a Notary Public, in and for Barton County, Kansas, this 27th day of January, 1969.

Ulanda Nichols

Ulanda Nichols



My Commission Expires:
April 1, 1971