

15-195-20302-00-00


STATE OF KANSAS
STATE CORPORATION COMMISSION

Form CP-4

WELL PLUGGING RECORD

Give All Information Completely
Make Required Affidavit
Mail or Deliver Report to:
Conservation Division
State Corporation Commission
P. O. Box 17027

Wichita, Kansas 67217
NORTH

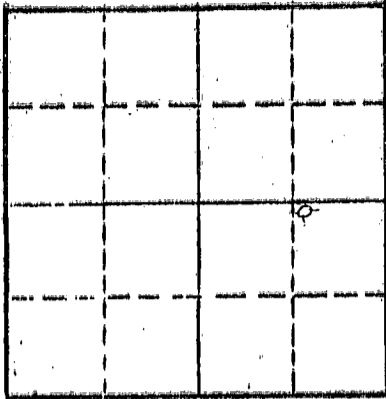

Locate well correctly on above
Section Plat

Trego County, Sec. 7 Twp. 13 Rge. 21W (E) (W)
Location as "NE/CNW/SE" or footage from lines NW-NE-SE
Lease Owner Donald C. Slawson
Lease Name Morton "A" Well No. #1
Office Address 408 120 Building
Character of Well (completed as Oil, Gas or Dry Hole) Dry Hole
Date well completed October 5 1974
Application for plugging filed October 5 1974
Application for plugging approved October 5 1974
Plugging commenced October 5 1974
Plugging completed October 5 1974
Reason for abandonment of well or producing formation Dry Hole

If a producing well is abandoned, date of last production 10
Was permission obtained from the Conservation Division or its agents before plugging was commenced? Yes

Name of Conservation Agent who supervised plugging of this well W. I. Nichols, P. O. Box 157, Merland, Kansas
Producing formation Depth to top Bottom Total Depth of Well 4033 Feet
Show depth and thickness of all water, oil and gas formations.

OIL, GAS OR WATER RECORDS

CASING RECORD

FORMATION	CONTENT	FROM	TO	SIZE	PUT IN	PULLED OUT
8 5/8"	240'				246'	

Describe in detail the manner in which the well was plugged, indicating where the mud fluid was placed and the method or methods used in introducing it into the hole. If cement or other plugs were used, state the character of same and depth placed, from feet to feet for each plug set.

1st plug @ 775' w/110 cu. ft.
2nd plug @ 250' w/30 cu. ft.
3rd plug @ 40' w/10 cu. ft.

RECEIVED
STATE CORPORATION COMMISSION
OCT 17 1974
CONSERVATION DIVISION
Wichita, Kansas

(If additional description is necessary, use BACK of this sheet)
Name of Plugging Contractor Slawson Drilling Company, Inc.
Address 408 120 Building, Wichita, Kansas 67202

STATE OF KANSAS COUNTY OF SEDGWICK
James C. Remsberg (employee of owner) or (owner or operator) of the above-described well, being first duly sworn on oath, says: That I have knowledge of the facts, statements, and matters herein contained and the log of the above-described well as filed and that the same are true and correct. So help me God.

(Signature) James C. Remsberg
James C. Remsberg, 408 120 Building, Wichita
(Address)

Subscribed and sworn to before me this 16th day of October, 1974
DOLORES B. COADY
STATE NOTARY PUBLIC
SEDGWICK COUNTY, KANSAS
Comm. Expires Mar. 7, 1976
Dolores B. Coady
Notary Public

WELL LOG

COMPANY: Donald C. Slawson
 408 120 Building
 Wichita, Kansas 67202

LEASE: #1 Morton "A"
 NW-NE-SE Sec. 7-13S-21W
 Trego County, Kansas

TOTAL DEPTH: 4033 feet

CONTRACTOR: Slawson Drilling Company, Inc.

COMMENCED: September 27, 1974

COMPLETED: October 5, 1974

CASING: Set 8 5/8" @246' w/175 sx

0-252	Surface Hole
252-1713	Shale
1713-2005	Shale and Shells
2005-2466	Shale
2466-3244	Lime and Shale
3244-3570	Shale
3570-3678	Lime and Shale
3678-4033	Lime
4033	RTD

RECEIVED
 STATE CORPORATION COMMISSION
 OCT 17 1974
 CONSERVATION DIVISION
 Wichita, Kansas

STATE OF KANSAS)
) SS
 COUNTY OF SEDGWICK)

I, JAMES C. REMSBERG, of the Slawson Drilling Company, Inc. upon oath state that the above and foregoing is a true and correct copy of the log of the #1 Morton "A" well.

James C. Remsberg
 JAMES C. REMSBERG

Subscribed and sworn to before me this 16th day of October, 1974.

Dolores B. Coady
 Dolores B. Coady, Notary Public

My Commission Expires:

DOLORES B. COADY
 STATE NOTARY PUBLIC
 SEDGWICK COUNTY, KANSAS
 Comm. Expires Mar. 7, 1976