


STATE OF KANSAS  
STATE CORPORATION COMMISSION

Form CP-4

Give All Information Completely  
Make Required Affidavit  
Mail or Deliver Report to:  
Conservation Division  
State Corporation Commission  
212 No. Market  
Wichita, Kansas 67202

15-051-05098-00-00  
WELL PLUGGING RECORD

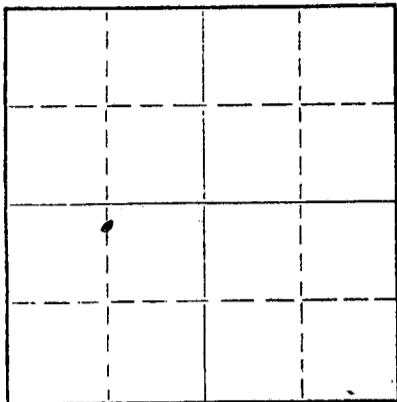

Locate well correctly on above Section Plat

Ellis County, Sec. 27 Twp. 13 Rge. (E) 17 (W)  
Location as "NE/CNW/SW" or footage from lines 0 N/2 N/2 SW/4  
Lease Owner Harms Petroleum Company  
Lease Name Weber Well No. 2  
Office Address Box 488, Great Bend, Kansas 67530  
Character of Well (completed as Oil, Gas or Dry Hole) oil  
Date well completed \_\_\_\_\_ 19\_\_\_\_  
Application for plugging filed September 14 19 70  
Application for plugging approved \_\_\_\_\_ 19\_\_\_\_  
Plugging commenced September 29 19 70  
Plugging completed September 29 19 70  
Reason for abandonment of well or producing formation depleted

If a producing well is abandoned, date of last production \_\_\_\_\_ 19\_\_\_\_  
Was permission obtained from the Conservation Division or its agents before plugging was commenced? yes

Name of Conservation Agent who supervised plugging of this well Leo Massey  
Producing formation \_\_\_\_\_ Depth to top \_\_\_\_\_ Bottom \_\_\_\_\_ Total Depth of Well 3537 Feet  
Show depth and thickness of all water, oil and gas formations.

OIL, GAS OR WATER RECORDS

CASING RECORD

FORMATION	CONTENT	FROM	TO	SIZE	PUT IN	PULLED OUT
		0	125'	8 5/8"	125'	none
		0	3528'	5 1/2"	3528'	none

Describe in detail the manner in which the well was plugged, indicating where the mud fluid was placed and the method or methods used in introducing it into the hole. If cement or other plugs were used, state the character of same and depth placed, from \_\_\_\_\_ feet to \_\_\_\_\_ feet for each plug set.

Plugged well with 10 sacks of mud plus 2 sacks of hulls and 150 sacks of cement.

RECEIVED  
STATE CORPORATION COMMISSION  
OCT 2 1970  
CONSERVATION DIVISION  
Wichita, Kansas

(If additional description is necessary, use BACK of this sheet)  
Name of Plugging Contractor PIPE PULLERS, INC.  
Address Box 486, Ellinwood, Kansas

STATE OF KANSAS, COUNTY OF BARTON, SS.  
Evelyn Roth (employee of owner) or (owner or operator) of the above-described well, being first duly sworn on oath, says: That I have knowledge of the facts, statements, and matters herein contained and the log of the above-described well as filed and that the same are true and correct. So help me God.

(Signature) Evelyn Roth  
Ellinwood, Kansas (Address)

SUBSCRIBED AND SWORN to before me this 1st day of October, 19 70

My commission expires Feb. 10, 1971

Serge A Meyer  
Notary Public.

D R I L L E R S   L O G

RECEIVED  
STATE CORPORATION COMMISSION  
SEP 15 1970  
CONSERVATION DIVISION  
Wichita, Kansas

COMPANY: Harms Petroleum Company  
FARM: Weber # 2  
COMMENCED: June 20, 1954  
  
ELEVATION: 1983 KB

C N/2 N/2 SW/4 Section 27-13-17. W  
Ellis County, Kansas  
Completed: July 2, 1954

----- 15-051-05098-00-00 -----

0 - 40	shale	2370 - 2505	shale & lime
40 - 55	sand	2505 - 2545	shale
55 - 125	shale	2545 - 2795	shale & lime
125 - 300	shale-shells	2795 - 2935	lime & shale
300 - 390	sand	2935 - 3035	shale
390 - 660	shale & red bed	3035 - 3135	lime & shale
660 - 830	sand	3135 - 3162	lime
830 - 1185	shale & shells	3162 - 3218	lime & shale
1185 - 1225	anhydrite	3218 - 3537	lime
1225 - 1825	shale & shells	3537	Total depth
1825 - 1875	shale - lime		
1875 - 1975	lime		
1975 - 2130	lime & shale		
2130 - 2210	lime		
2210 - 2370	lime & shale		

SET 125 feet of 8 5/8 inch casing.

CEMENTED with 100 sacks of cement with 2% calcium chloride.


SET 3828 feet 5 1/2 inch casing

CEMENTED with 75 sacks cement.


A F F I D A V I T


STATE OF KANSAS )  
                          ) SS  
COUNTY OF BARTON)

I, Allan Harms, of the Harms Drilling Company, being first duly sworn on oath state:  
I have knowledge of the facts, statements, and matters herein contained and the  
same are true and correct.

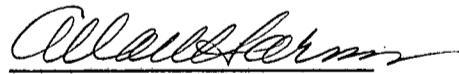  
Allan Harms

Subscribed and sworn to before me this 8th day of September, 1970

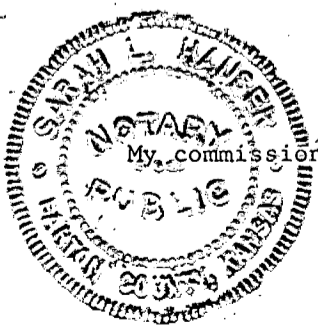

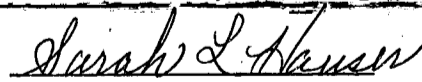  
Sarah L. Hauser  
Notary Public

My commission expires: May 4, 1974