


STATE CORPORATION COMMISSION

Give All Information Completely
Make Required Affidavit
Mail or Deliver Report to:
Conservation Division
State Corporation Commission
211 No. Broadway
Wichita, Kansas

15:05:04569:00:01
WELL PLUGGING RECORD

NORTH

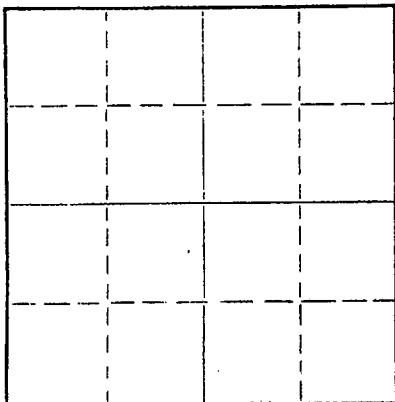

Locate well correctly on above
Section Plat

Ellis County. Sec. 27 Twp. 13 Rge. 17W(E) (W)

Location as "NE/CNW&SW&" or footage from lines NE SE NE
Lease Owner Murfin Drilling Company
Lease Name ROME "A" Well No. 2
Office Address 617 Union Center Bldg. - Wichita 2, Kansas
Character of Well (completed as Oil, Gas or Dry Hole) Old Hole Wash Down - Dry
Date well completed January 26, 1959 19
Application for plugging filed January 26, 1959 19
Application for plugging approved January 26, 1959 19
Plugging commenced January 26, 1959 19
Plugging completed January 26, 1959 19
Reason for abandonment of well or producing formation D & A

If a producing well is abandoned, date of last production 19
Was permission obtained from the Conservation Division or its agents before plugging was commenced? Yes

Name of Conservation Agent who supervised plugging of this well Eldon Petty - Hays, Kansas
Producing formation Depth to top Bottom Total Depth of Well 3613' Feet
Show depth and thickness of all water, oil and gas formations.

OIL, GAS OR WATER RECORDS

CASING RECORD

FORMATION	CONTENT	FROM	TO	SIZE	PUT IN	PULLED OUT
				8 5/8"	125'	None

Describe in detail the manner in which the well was plugged, indicating where the mud fluid was placed and the method or methods used in introducing it into the hole. If cement or other plugs were used, state the character of same and depth placed, from feet to feet for each plug set.

sacks

Set first plug @ 450' with 20 cement through drill pipe.
Fill hole to 120'. Set second plug with 1/2 sacks hulls
and 15 sacks cement. Fill hole to 40'. Set 3rd plug with
1/2 sack hulls and 10 sacks cement.

RECEIVED
STATE CORPORATION COMMISSION

JUL 21 1962
7-31-62
CONSERVATION DIVISION
Wichita, Kansas

(If additional description is necessary, use BACK of this sheet)

Name of Plugging Contractor Murfin Drilling Company
Address 617 Union Center Bldg. - Wichita 2, Kansas

STATE OF Kansas, COUNTY OF Sedgwick, ss.

I, W. R. Murfin - Partner (employee of owner) (owner) of the above-described well, being first duly sworn on oath, says: That I have knowledge of the facts, statements, and matters herein contained and the log of the above-described well as filed and that the same are true and correct. So help me God.

(Signature)

617 Union Center Bldg. - Wichita 2, Kansas
(Address)

SUBSCRIBED AND SWORN to before me this 25th day of July, 19 62My commission expires June 14, 1964

Notary Public.

