


STATE OF KANSAS
STATE CORPORATION COMMISSION

Give All Information Completely
Make Required Affidavit
Mail or Deliver Report to:
Conservation Division
State Corporation Commission
211 No. Broadway
Wichita, Kansas

15:05:02778:00:00
WELL PLUGGING RECORD

NORTH

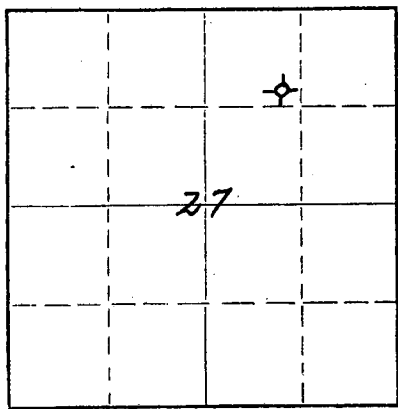

Locate well correctly on above
Section Plat

Ellis County, Sec. 27 Twp. 13 Rge. 17 (W)

Location as "NE/CNW/SW" or footage from lines SE-NW-NE
Lease Owner D. R. Lauck Oil Company, Inc.
Lease Name Geist Well No. 9
Office Address 301 South Broadway, Wichita, Kansas
Character of Well (completed as Oil, Gas or Dry Hole) Oil
Date well completed November 30 1955
Application for plugging filed March 14 1960
Application for plugging approved March 17 1960
Plugging commenced April 12 1960
Plugging completed April 19 1960
Reason for abandonment of well or producing formation Depleted

If a producing well is abandoned, date of last production March 20 1960
Was permission obtained from the Conservation Division or its agents before plugging was commenced? Yes

Name of Conservation Agent who supervised plugging of this well Mr. Eldon Petty
Producing formation Arbuckle Depth to top 3551 Bottom 3590 Total Depth of Well 3635 Feet
Show depth and thickness of all water, oil and gas formations. PB 3604

OIL, GAS OR WATER RECORDS

CASING RECORD

FORMATION	CONTENT	FROM	TO	SIZE	PUT IN	PULLED OUT
Lansing	Dry	3304	3545	8 5/8	140'	None
Arbuckle	Oil	3551	3590	5 1/2	3634'	2931'

Describe in detail the manner in which the well was plugged, indicating where the mud fluid was placed and the method or methods used in introducing it into the hole. If cement or other plugs were used, state the character of same and depth placed, from _____ feet to _____ feet for each plug set.

Sand 3604 - 3540
5 Sx. Cement 3540 - 3520
Pumped 14 Sx. Mud Gel through casing @ 500 ft.
Pumped 20 Sx. Cement @ 500 ft.
Pumped 20 Sx. Cement @ 190 ft.
10 Sx. Cement 35' to base cellar.

RECEIVED
STATE CORPORATION COMMISSION

MAY 20 1960

CONSERVATION DIVISION
Wichita, Kansas

(If additional description is necessary, use BACK of this sheet)

Name of Plugging Contractor _____
Address _____

STATE OF Kansas COUNTY OF Butler ss.
Harold E. Steele (employee of owner) or (owner or operator) of the above-described

well, being first duly sworn on oath, says: That I have knowledge of the facts, statements, and matters herein contained and the log of the above-described well as filed and that the same are true and correct. So help me God.

(Signature) [Signature]
Robert Lee Ellmwood Kans (Address)

Subscribed and Sworn to before me this 5th day of May, 1960
Catherine Honneke Notary Public.



My Commission Expires April 6, 1963

THE CARL TODD DRILLING COMPANY
 404 KFH Building
 Wichita, Kansas

15-051-02778-00-00

D. R. LAUCK, INC.
 #9 Geist
 SE NW NE Section 27-13S-17W
 Ellis County, Kansas

COMMENCED: November 14, 1955
COMPLETED: November 24, 1955

ELEVATION: 1992 DF

CASING RECORD

0 - 95	Shale
95 - 140	Shale and shells
140 - 350	Shale and shells
350 - 400	Sand and shale
400 - 550	Shale, iron & Red Bed
550 - 630	Sand and shale
630 - 675	Shale and shells
675 - 875	Sand
875 - 1180	Shale and Red Bed
1180 - 1215	Shale
1215 - 1245	Anhydrite
1245 - 1555	Shale and salt
1555 - 1880	Shale and shells
1880 - 1965	Lime
1965 - 2180	Shale and shells
2180 - 2295	Shale and lime
2295 - 2390	Lime and shale
2390 - 2695	Shale and shells
2695 - 3090	Lime and shale
3090 - 3100	Lime
3100 - 3295	Shale and lime
3295 - 3315	Lime
3315 - 3445	Lime
3445 - 3574	Lime
3574 - 3635	Lime
3635	Rotary Total Depth

8-5/8" OD 24# casing set at 140'
 with 125 sacks cement, 2 sacks CC

5-1/2" OD 14# casing set at 3634'
 cemented with 100 sacks

TOPS

Anhydrite	1215
Heebner	3259
Lansing	3304
Arbuckle	3551

DST #1 3314 - 44
 Open 1 hour, closed in 20", recovered
 65' watery mud. BHP 710#

DST #2 3353 - 74
 Open 1 hour, recovered 10' mud,
 BHP 0#

DST #3 3562 - 90
 Open 1 hour, closed in 20", recovered
 20' mud specked w/oil. BHP 195#

I hereby certify that the above is a true and correct log, to the best of my knowledge and belief.

THE CARL TODD DRILLING COMPANY

By:

Carl Todd