


Give All Information Completely  
Make Required Affidavit  
Mail or Deliver Report to:  
Conservation Division  
State Corporation Commission  
800 Bitting Building  
Wichita, Kansas

15-051-04570-00-00  
WELL PLUGGING RECORD

Ellis County, Sec. 27 Twp. 13S Rge. 17W (E) (W)

Location as "NE/CNW/SW" or footage from lines NE SW NW  
Lease Owner The Texas Company  
Lease Name James Geist Well No. 3  
Office Address 614 Bitting Building  
Character of Well (completed as Oil, Gas or Dry Hole) Dry hole  
Date well completed November 20 19 54  
Application for plugging filed (Verbal 11-20) November 22 19 54  
Application for plugging approved (Verbal 11-20) November 23 19 54  
Plugging commenced November 20 19 54  
Plugging completed November 20 19 54  
Reason for abandonment of well or producing formation \_\_\_\_\_

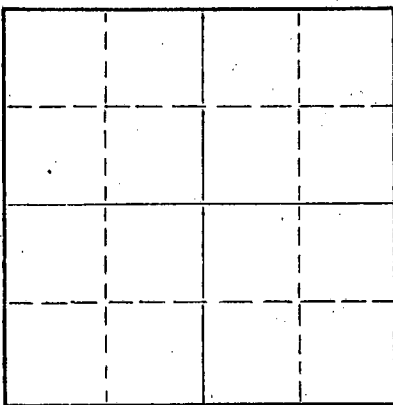

Locate well correctly on above Section Plat

If a producing well is abandoned, date of last production \_\_\_\_\_ 19\_\_\_\_  
Was permission obtained from the Conservation Division or its agents before plugging was commenced? Yes

Name of Conservation Agent who supervised plugging of this well Mr. Eldon Petty  
Producing formation \_\_\_\_\_ Depth to top \_\_\_\_\_ Bottom \_\_\_\_\_ Total Depth of Well 3640 Feet  
Show depth and thickness of all water, oil and gas formations.

OIL, GAS OR WATER RECORDS

CASING RECORD

FORMATION	CONTENT	FROM	TO	SIZE	PUT IN	PULLED OUT
				10-3/4"	1206'	0'

Describe in detail the manner in which the well was plugged, indicating where the mud fluid was placed and the method or methods used in introducing it into the hole. If cement or other plugs were used, state the character of same and depth placed, from \_\_\_\_\_ feet to \_\_\_\_\_ feet for each plug set.

PLUGGED AS FOLLOWS:

3640' to 300' - Heavy Mud  
300' to 250' - Dry hole plug, 1/2 sack hulls and 20 sacks cement  
250' to 35' - Heavy Mud  
35' to Bottom of Cellar - Dry hole plug, 1/2 sack hulls and 10 sacks cement

(If additional description is necessary, use BACK of this sheet)

Name of Plugging Contractor Noble Drilling Company  
Address Stanolind Building, Tulsa, Oklahoma

STATE OF Kansas, COUNTY OF Sedgwick, ss. M. C. Harrell (employee of owner) or (owner or operator) of the above-described well, being first duly sworn on oath, says: That I have knowledge of the facts, statements, and matters herein contained and the log of the above-described well as filed and that the same are true and correct. So help me God.

(Signature) M. C. Harrell  
614 Bitting Building, Wichita, Kansas (Address)

SUBSCRIBED AND SWORN to before me this 29th day of November, 1954

H. Howard Kistler  
Notary Public.

My commission expires September 20, 1956

PLUGGING  
FILE SEC 27 T 13 R 17W  
BOOK PAGE 29 LINE 14

12-1-54

DRILLING LOG

15.051.04570.00.00

The Texas Co - James Geist No. 3 Well, located in Sec. 27,  
Twp 13 So., Rge 17 West, Ellis County, Kansas.

Started 11-10-54

Completed 11-20-54

Casing Set 10-3/4" at 1206' with 600 Sax at 12:15 P M  
11-12-54 W O C 24 Hours

0 - 40 Surface Clay & Sand  
40 - 266 Blue Clay & Shale  
266 - 600 Blue & Gray Shale  
600 - 875 Shale & Gyp  
875 - 920 Shale & Sand  
920 - 1078, Red Shale & Gyp  
1078 - 1193 Red Shale  
1193 - 1379 Anhydrite  
1379 - 1778 Shale & Anhydrite  
1778 - 1878 Shale  
1878 - 2035 Shale & Lime  
2035 - 2150 Lime & shale  
2150 - 2515 Lime  
2515 - 3234 Lime & shale  
3234 - 3640 T.D. Lime

**PLUGGING**  
FILE SEC 27, 13, R 17W  
BOOK PAGE 29 LINE 14.



# LOG OF WELL

SHEET No. 2

District **Kansas**

Owner **The Texas Company Farm James Geist**

Well No. **3**

FORMATION		AMOUNT	COLOR	HARD OR SOFT	DEPTH CORES TAKEN	REMARKS
<b>REMARKS:</b>						
11-20-54	Drilled to 3640' in Conglomerate and ran Schlumberger Survey. Well dry. Plugged and abandoned.					
<b>TOPS:</b>						
Topeka-----3006						
Heebner-----3255						
Lansing-----3301						
Conglomerate-----3533						
<div style="text-align: right; margin-top: 20px;"> <p>3255 1989 ----- 1366 55</p> </div>						