


STATE OF KANSAS  
STATE CORPORATION COMMISSION

15-051-04297-00-00  
WELL PLUGGING RECORD

Give All Information Completely  
Make Required Affidavit  
Map or Deliver Report to:  
Conservation Division  
State Corporation Commission  
800 Bittling Building  
Wichita, Kansas

NORTH

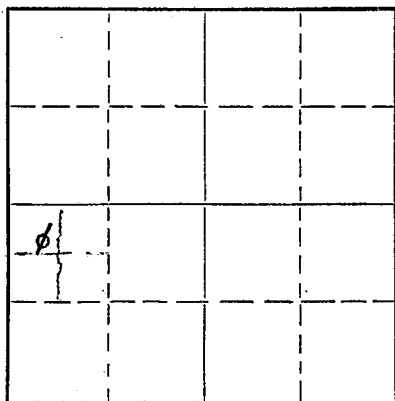

Locate well correctly on above  
Section Plat

Ellis County. Sec. 27 Twp. 13S. Rge. (E) 17(W)

Location as "NE/CNW $\frac{1}{4}$ SW $\frac{1}{4}$ " or footage from lines 330' EWL & 330' SNL of SW $\frac{1}{4}$   
Lease Owner Gulf Oil Corporation  
Lease Name Anna B. Weber Well No. 1  
Office Address Box 661, Tulsa 2, Oklahoma  
Character of Well (completed as Oil, Gas or Dry Hole) Dry Hole  
Date well completed April 9, 1952  
Application for plugging filed Verbally April 12, 1952  
Application for plugging approved Verbally April 12, 1952  
Plugging commenced April 12, 1952  
Plugging completed April 12, 1952  
Reason for abandonment of well or producing formation Dry Hole

If a producing well is abandoned, date of last production 19  
Was permission obtained from the Conservation Division or its agents before plugging was commenced? Yes

Name of Conservation Agent who supervised plugging of this well Mr. Eldon Petty  
Producing formation Arbuckle Depth to top 3519' Bottom 3544' Total Depth of Well 3544' Feet  
Show depth and thickness of all water, oil and gas formations.

OIL, GAS OR WATER RECORDS

CASING RECORD

Formation	Content	From	To	Size	Put In	Pulled Out
				8-5/8" OD	204'	0'

Describe in detail the manner in which the well was plugged, indicating where the mud fluid was placed and the method or methods used in introducing it into the hole. If cement or other plugs were used, state the character of same and depth placed, from \_\_\_\_\_ feet to \_\_\_\_\_ feet for each plug set.

Filled to 200' with heavy mud and 20 sacks of cement spotted through drill pipe on HOWCO plug. Filled to 40' with mud; HOWCO plug with 1/2 sack hulls at 40' and 10 sacks of cement spotted on plug.

APR 16 1952  
4-16-52  
CONSERVATION DIVISION  
WICHITA, KANSAS


(If additional description is necessary, use BACK of this sheet)

Name of Plugging Contractor Glenn W. Peel  
Address P. O. Box 359, Hoisington, Kansas

STATE OF Kansas COUNTY OF Rice, ss.  
W. H. Duley (employee of owner) or (owner or operator) of the above-described well,  
being first duly sworn on oath, says: That I have knowledge of the facts, statements, and matters herein contained and the log of the above-described well as filed and that the same are true and correct. So help me God.

(Signature) W. H. Duley  
P. O. Box 544, Chase, Kansas (Address)

SUBSCRIBED AND SWORN to before me this 15th day of April, 1952  
My commission expires April 14, 1956  
M. Council Notary Public

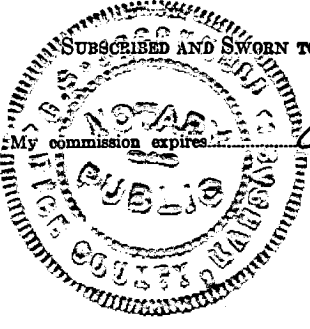

PLUGGING  
FILE SEC 27 T 13 R 17W  
BOOK PAGE 8 LINE 40

F



DRILLER'S

LOG

Company: Gulf Oil Corporation  
 Farm: Weber Well No. 1  
 Comm: 3-27-52 Comp: 4-12-52  
 Total Depth: 3544'  
 Contractor: Peel Brothers, Inc.  
 Casing: 8 5/8" @ 213' cem.

Center NW NW SW  
 Sec. 27, Twp. 13S, Rge. 17W,  
 County; Ellis,  
 Kansas  
 Elevation:  
 Production: Dry

Figures below indicate bottom of formations

Shale	0'	320
Sand		370
Red Bed and Shale		425
Shale and Sand		480
Shale		570
Shale and Shells		650
Shale and Sand		720
Sand, Shale and Red Bed		780
Red Bed		1050
Shale		1165
Anhydrite		1200
Shale and Shells		1475
Shale and Sand		1550
Shale and Shells		1675
Shale		1820
Lime		1855
Iron and Lime Streaks		1900
Shale and Anhydrite Streaks		2035
Shale and Lime Streaks		2135
Shale and Lime		2225
Lime		2650
Lime and Shale		3105
Lime		3510
Lime and Shale		3530
Arbuckle Lime		3534
Conglomerate Shale		3544
Total Depth		3544

This is to certify that the above information is to the best of my knowledge true and correct.

PEEL BROTHERS, INC.,

BY: Mendell E. Peel

SUBSCRIBED AND SWORN to before me this 12th day of April, 1952.



Bernice C. Jervis  
Notary Public - Barton County, Kans.

My commission expires April 23, 1955.