


STATE OF KANSAS
STATE CORPORATION COMMISSION

1605104434-0000
WELL PLUGGING RECORD

Give All Information Completely
Make Required Affidavit
Mail or Deliver Report to:
Conservation Division
State Corporation Commission
800 Blitting Building
Wichita, Kansas

NORTH

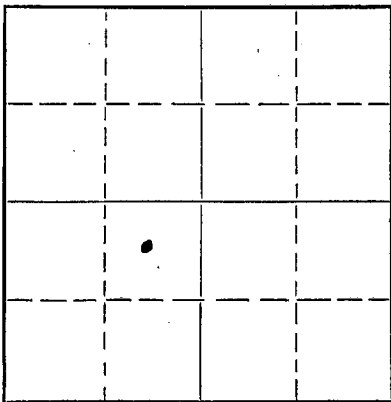

Locate well correctly on above
Section Plat

Ellis County. Sec. 27 Twp. 13S Rge. (E) 17(W)
Location as "NE/CNW $\frac{1}{4}$ SW $\frac{1}{4}$ " or footage from lines 330' SWL 330' WEL of SW $\frac{1}{4}$
Lease Owner Gulf Oil Corporation
Lease Name Anna B. Weber Well No. 2
Office Address Box 661, Tulsa, Oklahoma
Character of Well (completed as Oil, Gas or Dry Hole) Dry Hole
Date well completed July 14, 19 52
Application for plugging filed July 14 (verbal) 19 52
Application for plugging approved July 14 (verbal) 19 52
Plugging commenced July 15 19 52
Plugging completed July 15 19 52
Reason for abandonment of well or producing formation Dry Hole

If a producing well is abandoned, date of last production _____ 19____
Was permission obtained from the Conservation Division or its agents before plugging was commenced? Yes

Name of Conservation Agent who supervised plugging of this well Mr. Eldon Petty
Producing formation Arbuckle Depth to top 3599 Bottom _____ Total Depth of Well 3615 Feet
Show depth and thickness of all water, oil and gas formations.

OIL, GAS OR WATER RECORDS

CASING RECORD

Formation	Content	From	To	Size	Put In	Pulled Out
				8-5/8"	199'	0

Describe in detail the manner in which the well was plugged, indicating where the mud fluid was placed and the method or methods used in introducing it into the hole. If cement or other plugs were used, state the character of same and depth placed, from _____ feet to _____ feet for each plug set.

Pushed Halliburton plug/200' and spotted 15 sacks cement on plug, then mud to 40', Halliburton plug set at 40'.
Spotted 10 sacks cement through DP to surface.


RECEIVED
STATE CORPORATION COMMISSION
JUL 18 1952
7-18-52
CONSERVATION DIVISION
Wichita, Kansas

Name of Plugging Contractor Glenn W. Peel
Address PO Box 359
Holsington, Kansas

STATE OF Kansas COUNTY OF Rice, ss.
W. H. Duley (employee of owner) or owner of the above-described well,

being first duly sworn on oath, says: That I have knowledge of the facts, statements, and matters herein contained and the log of the above-described well as filed and that the same are true and correct. So help me God.

(Signature) W. H. Duley
P. O. Box 544, Chase, Kansas
(Address)

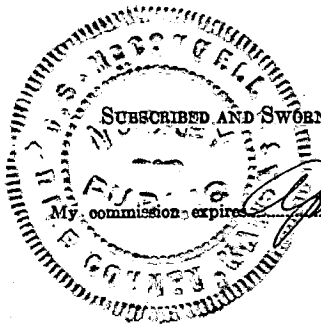

W. H. Duley
Notary Public.

23-8390-s 6-51-20M

PLUGGING
FILE SEC 27-13-126
BOOK PAGE 31 LINE 7

jab

WELL NO. 2 LEASE Anna B. Weber COMPANY Gulf Oil Corporation A.F.E. 2956
 DATE—DRILLING BEGAN 7-2-52 ~~BOOK~~ ^{plugging} COMPLETED 7-15-52 FIRST PRODUCTION —
 SAND RECORD Dry - Arbuckle top 3599' TOTAL DEPTH 3615'
 INITIAL PRODUCTION Dry Hole Plugged & Abandoned 15-051-04434-00-00

CASING RECORD

SIZE	WEIGHT	THD.	CLASS	MAKE	SET AT DEPTH	SACKS CEMENT	LBS. CAL. CHLO.	PULLED	LEFT IN
8-5/8"	32#	10-V	C-1	Smls.	210'	125	200		210'

S— 27 T— 13S R— 17W

				Center
				NE
				NE
				SW
				ELLIS
				COUNTY,
				KANSAS

ELEVATION— DF 1985'
KB 1988'

FORMATION RECORD:

	FROM	TO:
Sod & sand	0'	70
Shale & shells		214
Shale & sand		575
Sand		825
Shale & shells		855
Shale & sand, red bed		1195
Anhydrite		1225
Shale & shells		1900
Broken lime & shale		2125
Shale & lime		3035
Lime		3557
Conglomerate		3599
Dolo.		3615
TD		3615

PLUGGING
 FILE NO. 27 T 13 R 17W
 BOOK PAGE 31 LINE 7

RECEIVED
 STATE CORPORATION COMMISSION
 AUG 13 1952
 CONSERVATION DIVISION
 Wichita, Kansas