


Give All Information Completely  
Make Required Affidavit  
Mail or Deliver Report to:  
Conservation Division  
State Corporation Commission  
800 Biting Building  
Wichita, Kansas

OR

FORMATION PLUGGING RECORD

Strike out upper line  
when reporting plug-  
ging off formations.

NORTH

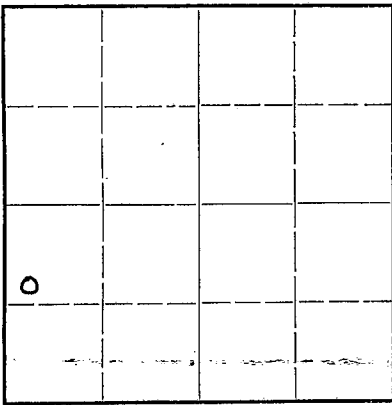

Locate well correctly on above  
Section Plat

Location as "NE $\frac{1}{4}$ NW $\frac{1}{4}$ SW $\frac{1}{4}$ " or footage from lines. SW $\frac{1}{2}$  NW $\frac{1}{2}$  SW $\frac{1}{2}$   
 County. Sec. 18 Twp. 13S Rge. 19W(E).....(W)  
 Lease Owner. Continental Oil Co.  
 Lease Name. Disney Well No. 1  
 Office Address. Ponca City, Oklahoma  
 Character of Well (completed as Oil, Gas or Dry Hole) Stratigraphic Test  
 Date well completed. April 23, 1944  
 Application for plugging filed. April 24, 1944  
 Application for plugging approved. April 24, 1944  
 Plugging commenced. April 24, 1944  
 Plugging completed. April 24, 1944  
 Reason for abandonment of well or producing formation.....

If a producing well is abandoned, date of last production.....19.....  
 Was permission obtained from the Conservation Division or its agents before plugging was com-  
 menced? Yes

Name of Conservation Agent who supervised plugging of this well. Eldon Petty  
 Producing formation..... Depth to top..... Bottom..... Total Depth of Well..... Feet  
 Show depth and thickness of all water, oil and gas formations.

OIL, GAS OR WATER RECORDS


CASING RECORD

Formation	Content	From	To	Size	Put In	Pulled Out
				8 5/8	90'	0'

Describe in detail the manner in which the well was plugged, indicating where the mud fluid was placed and the method or methods used in introducing it into the hold. If cement or other plugs were used, state the character of same and depth placed, from.....feet to.....feet for each plug set.

The hole was filled with heavy rotary mud to 100 feet where a bridge was set and cemented ~~with~~ to approximately 60 feet. The hole was then filled with mud to 25 feet where a plug was set and the hole filled with cement.

**PLUGGING**  
 FILE EC-18-13-R194  
 BOOK PAGE 115 LINE 4

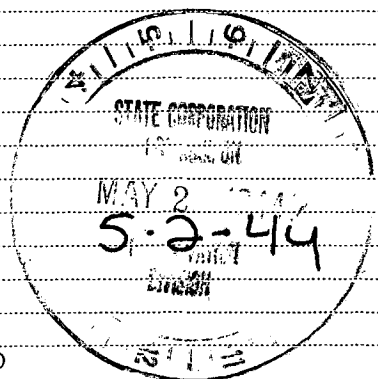

(If additional description is necessary, use BACK of this sheet)

Correspondence regarding this well should be addressed to J. George Klein  
 Address Box 120 Hays, Kansas

STATE OF Kansas, COUNTY OF Ellis, ss.  
 J. George Klein (employee of owner) or (owner or operator) of the above-described well,  
 being first duly sworn on oath, says: That I have knowledge of the facts, statements, and matters herein contained and the log of the above-described well as filed and that the same are true and correct. So help me God.

(Signature)

Hays, Kansas  
 (Address)

SUBSCRIBED AND SWORN to before me this First day of May, 1944

My commission expires

Apr. 27, 1946

