

Give All Information Completely
Make Required Affidavit
Mail or Deliver Report to:
Conservation Division
State Corporation Commission
800 Bitting Building
Wichita, Kansas


OR
FORMATION PLUGGING RECORD

Strike out upper line
when reporting plug-
ging off formations.

Ellis County, Sec 9 Twp 13 Rge 18 (E) (W)

Location as "NE $\frac{1}{4}$ NW $\frac{1}{4}$ SW $\frac{1}{4}$ " or footage from lines SE SW NW
Lease Owner Aledo & Brunson
Lease Name Drilling
Office Address 301-304 Central Building, Wichita, Kansas
Character of Well (completed as Oil, Gas or Dry Hole) Dry Hole
Date well completed 12-23 19
Application for plugging filed 12-23 19
Application for plugging approved 12-23 19
Plugging commenced 12-23 19
Plugging completed 12-23 19
Reason for abandonment of well or producing formation Dry Hole

If a producing well is abandoned, date of last production 19
Was permission obtained from the Conservation Division or its agents before plugging was com-
menced? Yes

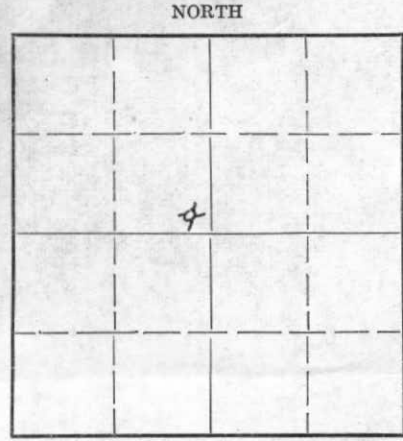

Locate well correctly on above
Section Plat

Name of Conservation Agent who supervised plugging of this well Mr. C. D. Stough
Producing formation Depth to top Bottom Total Depth of Well 3886 Feet
Show depth and thickness of all water, oil and gas formations.

OIL, GAS OR WATER RECORDS

CASING RECORD

Formation	Content	From	To	Size	Put In	Pulled Out
				8-5/8"	207	

Describe in detail the manner in which the well was plugged, indicating where the mud fluid was placed and the method or methods used in introducing it into the hole. If cement or other plugs were used, state the character of same and depth placed, from feet to feet for each plug set.

Filled hole with heavy mud to 200 ft. Set wooden plug at 200 ft. Mixed and pumped 15 sacks of cement on top of plug (through drill pipe). Filled hole with heavy mud to 25 ft. Set wooden plug at 25 ft. Mixed and dumped 10 sacks of cement on plug.

RECEIVED
1-7-49
JAN 7 - 1949

(If additional description is necessary, use BACK of this sheet)
Correspondence regarding this well should be addressed to Brunson Drilling Co., Inc. Conservation Division
Address 301-304 Central Building, Wichita, Kansas

STATE OF Kansas, COUNTY OF Sedwick, ss.
W. S. Brunson (employee of owner) or (owner or operator) of the above-described well,
being first duly sworn on oath, says: That I have knowledge of the facts, statements, and matters herein contained and the log of the above-described well as filed and that the same are true and correct. So help me God. BRUNSON DRILLING COMPANY, INC.
(Signature) William S. Brunson
301-304 Central Bldg. Wichita, Kansas (Address)

SUBSCRIBED AND SWORN to before me this 14th day of January, 1949
My commission expires September 10, 1951

Jan C. Detwiler
Notary Public.



PLUGGING
FILE SEC 9 T 13 R 18 W
BOOK PAGE 77 LINE 33

Aledo Oil & Gas Co., Inc.
and
BRUNSON DRILLING COMPANY, INC. et al

L. J. Drilling #1

Sec. 9-136-18W
Ellis County, Kansas

Commenced RD: 12/12/48
Completed RD: 12/23/48
Total Depth: 3886'

Elevation : 2174' (R.B.)
Initial Prod: Dry
Contractor : Brunson Drlg. Co., Inc.

Casing: 207' - 8 1/2"

15-051-00922-00-00

STRATA	DEPTH		
Surface soil	15		
Soft lime & shale	210		
Shale	260		
Shale & shell	561		
Sand & shale	685		
Shale & shells	915		
Sand & pyrite	1150		
Shale & redbed	1472		
Anhydrite	1565		
Shale	1915		
Salt & shale	2010		
Shale & shells	2140		
Salt & shale	2200		
Shale & shells	2360		
Broken lime	2375		
Broken lime & shale	2440		
Broken lime	2770		
Lime & shale	3136		
Shale & shells	3215		
Shale & lime	3563		
Broken lime	3620		
Lime & shale	3681		
Broken lime	3727		
Shale & lime	3747		
Conglomerate	3830		
Lime	3886		
Total Depth	3886		

TYPE	
Reebner	3436
Dodge	3472
Lansing	3488
Cherty cong	3748
Arnschie	3874

I hereby certify that the above is a true and correct log of said well as reflected by the daily drilling reports.

BRUNSON DRILLING COMPANY, INC.
By

William F. Brunson
Wm. F. Brunson Sec.

Signed and sworn to in my presence this 5th day of January, 1949, by Wm. F. Brunson, secretary of the Brunson Drilling Company, Inc., a corporation in the State of Kansas.

James C. [Signature]
Notary Public

My commission expires September 10, 1951.

PLUGGING
FILE SEC 9-T-13-R-180
BOOK PAGE 77 LINE 33

JAN 7 - 1949
STATION
SON
3

