


Give All Information Completely
Make Required Affidavit
Mail or Deliver Report to:
Conservation Division
State Corporation Commission

P. O. Box 17027
Wichita, Kansas 67217
NORTH

WELL PLUGGING RECORD

Ness County, Sec. 12 Twp. 20S Rge. 24W (E) (W) XX

Location as "NE/CNW/SW" or footage from lines NE SE
Lease Owner Thunderbird Drilling, Inc.
Lease Name Petersilie "B" Well No. 1
Office Address Suite 780, 7701 E. Kellog, Wichita, Kansas 67218
Character of Well (completed as Oil, Gas or Dry Hole) D & A
Date well completed December 1 1973
Application for plugging filed December 1 1973
Application for plugging approved December 1 1973
Plugging commenced December 1 1973
Plugging completed December 1 1973
Reason for abandonment of well or producing formation D & A

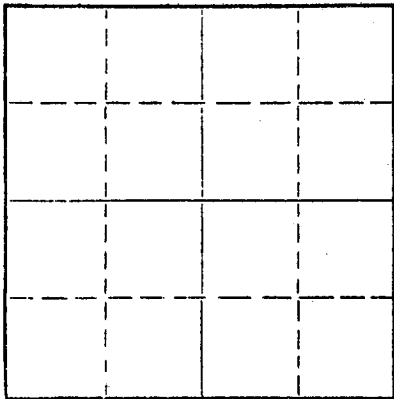

Locate well correctly on above
Section Plat

If a producing well is abandoned, date of last production 19
Was permission obtained from the Conservation Division or its agents before plugging was commenced? Yes

Name of Conservation Agent who supervised plugging of this well Leo F. Massey
Producing formation _____ Depth to top _____ Bottom _____ Total Depth of Well 4490' Feet
Show depth and thickness of all water, oil and gas formations.

OIL, GAS OR WATER RECORDS

CASING RECORD

FORMATION	CONTENT	FROM	TO	SIZE	PUT IN	PULLED OUT
				8-5/8"	540'	-0-

Describe in detail the manner in which the well was plugged, indicating where the mud fluid was placed and the method or methods used in introducing it into the hole. If cement or other plugs were used, state the character of same and depth placed, from _____ feet to _____ feet for each plug set.

First Plug: 30 sx cement @ 480'
Second Plug: 25 sx cement @ 240'
Third Plug: 10 sx cement @ 50-50
Pozmix - 2% Gel @ 40'

RECEIVED
STATE CORPORATION COMMISSION

DEC 11 1973

CONSERVATION DIVISION
Wichita, Kansas

(If additional description is necessary, use BACK of this sheet)

Name of Plugging Contractor Red Tiger Drilling Company
Address 1720 Wichita Plaza, Wichita, Kansas 67202

STATE OF Kansas, COUNTY OF Sedgwick, ss.

(employee of owner) or (owner or operator) of the above-described well, being first duly sworn on oath, says: That I have knowledge of the facts, statements, and matters herein contained and the log of the above-described well as filed and that the same are true and correct. So help me God.

(Signature) [Signature]
1720 Wichita Plaza, Wichita, Kansas 67202
(Address)

SUBSCRIBED AND SWORN TO before me this 5th day of December, 19 73

Linda H. Dickens
Notary Public.



15-135-20807-0000

DRILLERS LOG

Petersilie "B"

CASING RECORD:

8-5/8" @ 540'
w/275 sx cement

TOTAL DEPTH: 4490'

COMPANY: Thunderbird Drilling, Inc.

CONTRACTOR: Red Tiger Drilling, Inc.

COMMENCED: November 13, 1973

COMPLETED: December 1, 1973

DESCRIPTION:

NE SE
12-20S-24W
Ness County
Kansas

ELEVATION:

<u>FORMATION</u>	<u>FROM</u>	<u>TO</u>	<u>REMARKS</u>
Shale	0	558	
Shale & Redbed	558	845	
Shale & Hard Sand	845	1595	
Anhydrite	1595	1609	
Shale	1609	2210	
Shale & Lime	2210	2530	
Shale	2530	2620	
Shale & Lime	2620	3245	
Lime	3245	3350	
Lime & Shale	3350	3490	
Lime	3490	3625	
Shale	3625	3740	
Lime & Shale	3740	3780	
Lime	3780	4230	
Lime & Chalk	4230	4275	
Lime	4275	4409	
Dolomite	4409	4430	
Lime	4430	4490	

RECEIVED
STATE CORPORATION COMMISSION
DEC 11 1973
CONSERVATION DIVISION
Wichita, Kansas

I certify that this is a true and correct copy of the above log to the best of my knowledge.

RED TIGER DRILLING COMPANY

D'Ann Drennan
D'Ann Drennan

Subscribed and sworn to before me this 5th day of December, 1973.

Linda H. Dickens
Notary Public

My Commission Expires:

March 8, 1977

