


STATE OF KANSAS  
STATE CORPORATION COMMISSION

15-009-21721-0000

WELL PLUGGING RECORD

Give All Information Completely  
Make Required Affidavit  
Mail or Deliver Report to  
Conservation Division  
State Corporation Comm.  
245 North Water  
Wichita, KS 67202

Barton County. Sec. 20 Twp. 26 Rge. 13 E/W  
Location as "NE/CNW $\frac{1}{4}$ SW $\frac{1}{4}$ " or footage from lines  
NE NW SW  
Lease Owner Crude Producers, Inc.  
Lease Name Redetzke Well No. 2  
Office Address Box 55, Russell, KS 67665  
Character of Well (Completed as Oil, Gas or Dry Hole)

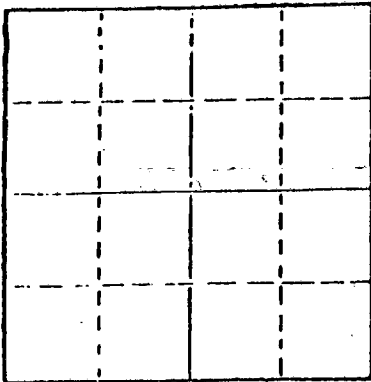

Locate well correctly on above  
Section Plot

Dry Hole  
Date Well completed 10-23 1979  
Application for plugging filed 10-23 1979  
Application for plugging approved 10-23 1979  
Plugging commenced 10-23 1979  
Plugging completed 10-23 1979  
Reason for abandonment of well or producing formation  
Dry Hole

If a producing well is abandoned, date of last production  
19

Was permission obtained from the Conservation Division or  
its agents before plugging was commenced? Yes

Name of Conservation Agent who supervised plugging of this well Duane Rankin  
Producing formation \_\_\_\_\_ Depth to top \_\_\_\_\_ Bottom \_\_\_\_\_ Total Depth of Well 3407'  
Show depth and thickness of all water, oil and gas formations.

OIL, GAS OR WATER RECORDS

CASING RECORD

FORMATION	CONTENT	FROM	TO	SIZE	PUT IN	PULLED OUT
				8 5/8"	266'	NONE

Describe in detail the manner in which the well was plugged, indicating where the mud fluid  
was placed and the method or methods used in introducing it into the hole. If cement or other  
plugs were used, state the character of same and depth placed, from \_\_\_\_\_ feet to  
\_\_\_\_\_ feet for each plug set.

Plug @ 50 sks @ 480'  
25 sks @ 240'  
10 sks @ 40'  
2 sks in rathole - 50/50 Pozmix  
By Allied - P.D. @ 12:30 p.m.

RECEIVED  
STATE CORPORATION COMMISSION  
11-8-79  
NOV 08 1979  
CONSERVATION DIVISION  
Wichita, Kansas

(If additional description is necessary, use BACK of this sheet)

Name of Plugging Contractor ALLEN DRILLING CO.  
P. O. BOX 1389  
GREAT BEND, KANSAS 67530

STATE OF Kansas COUNTY OF Barton, ss.  
Allen Drilling Company (employee of owner) or (owner or operator)  
of the above-described well, being first duly sworn on oath, says: That I have knowledge of  
the facts and statements, and matters herein contained and the log of the above-described well  
as filed and that the same are true and correct. So help me God.



(Signature) James R. Hally  
P. O. Box 1389, Great Bend, KS 67530  
(Address)

SUBSCRIBED AND SWORN TO before me this 25th day of October, 1979

Wanda Nichols  
Notary Public.

My commission expires 1-28-1980

15-009-21721-0000

DRILLER'S WELL LOG

DATE COMMENCED: 10-17-79  
DATE COMPLETED: 10-23-79

Crude Producers, Inc.  
Redetzke #2  
NE NW SW, Sec. 20-16-13W,  
Barton County, Kansas

ELEVATIONS 1959' K.B.  
1954' G.L.  
1956' D.F.  
FORMATION DATA

910- 935' Anhydrite  
2842-3077' Lime  
3077-3082' Shale  
3082-3096' Lime  
3096-3111' Lime  
3111-3158' Shale  
3158-3168' Lime and Shale  
3168-3390' Lime  
3390-3407' Dolomite  
3407' RTD

Anhydrite 910  
Topeka 2842  
Heebner 3077  
Toronto 3096  
Douglas 3111  
Brown Lime 3158  
Lansing/KC 3168  
Arbuckle 3390  
RTD 3407

SURFACE PIPE:  
Ran 9 Jts. 8 5/8" Used Surface Csg.  
Pipe Tally 259'. Set @ 266'  
w/160 sks. Cement - 60/40 Pozmix,  
2% Gel, 3% c.c.  
Cement did Circulate  
P.D. @ 8:30 p.m.

By Allied  
PLUGGING:  
50 sks. @ 480'  
25 sks. @ 240'  
10 sks. @ 40'  
2 sks. in rathole  
50-50 Pozmix. By Allied.  
P.D. 12:30 p.m. 10-23-79  
Orders by Duane Rankin

RECEIVED  
STATE CORPORATION COMMISSION

NOV 08 1979

CONSERVATION DIVISION  
Wichita, Kansas


AFFIDAVIT

STATE OF KANSAS )  
COUNTY OF BARTON) ss.

JAMES R. HOLLEY, of lawful age, does swear and state that the facts and statements herein contained are true and correct to the best of his knowledge.

*James R. Holley*

Subscribed and sworn to before me this 25th day of October 1979

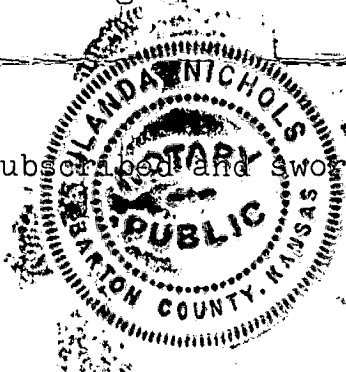

*Landa Nichols*  
(Notary Public)

My commission Expires: 1-28-1980