


STATE OF KANSAS
STATE CORPORATION COMMISSION

Give All Information Completely
Make Required Affidavit
Mail or Deliver Report to:
Conservation Division
State Corporation Commission
800 Biting Building
Wichita, Kansas

15-051-00476-00-00
WELL PLUGGING RECORD

Ellis County, Sec. 28 Twp. 13 Rge. 17 (E) (W)

Location as "NE/CNW/SW" or footage from lines C E 1/2 NW NW
Lease Owner Glenn R. Nye et al
Lease Name Katherine Bissing Well No. #3
Office Address Drawer 30, Hays, Kansas
Character of Well (completed as Oil, Gas or Dry Hole) Dry Hole
Date well completed October 25 19 54
Application for plugging filed October 25 19 54
Application for plugging approved October 25 19 54
Plugging commenced October 25 19 54
Plugging completed October 25 19 54
Reason for abandonment of well or producing formation _____

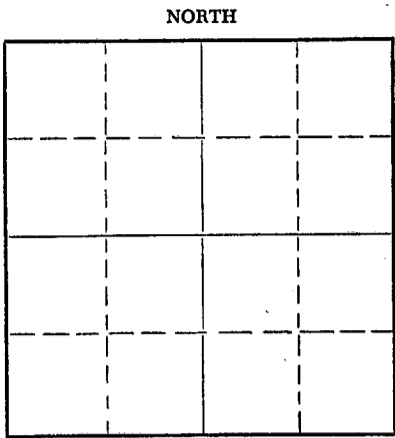

Locate well correctly on above
Section Plat

If a producing well is abandoned, date of last production _____ 19 _____
Was permission obtained from the Conservation Division or its agents before plugging was commenced? yes

Name of Conservation Agent who supervised plugging of this well Eldon Petty
Producing formation _____ Depth to top _____ Bottom _____ Total Depth of Well 3613 Feet
Show depth and thickness of all water, oil and gas formations.

OIL, GAS OR WATER RECORDS

CASING RECORD

FORMATION	CONTENT	FROM	TO	SIZE	PUT IN	PULLED OUT
				8 5/8"	120'	none

Describe in detail the manner in which the well was plugged, indicating where the mud fluid was placed and the method or methods used in introducing it into the hole. If cement or other plugs were used, state the character of same and depth placed, from _____ feet to _____ feet for each plug set.

Filled hole with heavy drilling mud to 120', set first plug at 120' with 1/2 sack hulls and 15 sacks portland cement, set second plug at 40' with 1/2 sack hulls and 10 sacks cement, cement filled hole to bottom of cellar.

Rec'd

10-30-54

(If additional description is necessary, use BACK of this sheet)
Name of Plugging Contractor Nye & Snell Drilling Company
Address Drawer 30, Hays, Kansas

STATE OF Kansas, COUNTY OF Ellis, ss.
Carl Quattlebaum (employee of owner) or (owner or operator) of the above-described well, being first duly sworn on oath, says: That I have knowledge of the facts, statements, and matters herein contained and the log of the above-described well as filed and that the same are true and correct. So help me God.

(Signature) Carl Quattlebaum
Hays, Kansas (Address)

SUBSCRIBED AND SWORN to before me this 28th day of October, 1954

John L. Spiess
Notary Public.

My commission expires May 9, 1957

24-7368-5 3-53-20M

PLUGGING
FILE SEC 28 T 13 R 17
BOOK PAGE 23 LINE 28

Company: Glenn R. Nye Drilling Co. Farm: Katherine Bissing #3
 Contractor: Nye & Snell Drilling Co. Location: C E 1/2 NW NW, Sec. 28-13-17,
 Commenced: October 15, 1954 Ellis County, Kansas
 Completed: October 25, 1954 Casing Record: 8 5/8" set at 120'
 Elevation: 2027' K.B. Dry and Abandoned

15-051-00476-00-00
 (figures below indicate bottoms)

sand & shale	120	
sand & shale	450	
shale & sand	885	
shale & red bed	1233	Anhydrite 1233
anhydrite	1245	
anhydrite	1271	
red bed, pyrite & shale	1525	
red bed & shale	1850	
shale & lime	2030	
shale & lime	2170	
lime & shale	2300	
shale & lime	2385	
shale & lime	2455	
shale & lime	2555	
shale & lime	2695	
shale & lime	2810	
lime & shale	2910	
shale & lime	3045	
shale & lime	3090	
lime & shale	3170	
lime & shale	3230	Heebner 3249 (-1222)
shale & lime	3277	Lansing 3294 (-1267)
lime & shale	3355	
lime & shale	3378	
lime	3397	
lime	3410	
lime	3465	
lime & shale	3525	Base K.C. 3530
conglomerate	3555	Conglomerate 3540 (-1513)
conglomerate	3605	
conglomerate	3613	T.D.

I hereby certify that this is a true and correct log of the above described well as shown by the drilling reports.

Glenn R. Nye Drilling Company

By Ernst J. Zentgraf

STATE OF KANSAS)
) SS
 ELLIS COUNTY)

Subscribed and sworn to before me, a Notary Public, in and for said County and State this 28 day of Oct., 1954.



John L. Spess
 Notary Public

My Commission Expires May 9, 1957

PLUGGING
 FILE SEC 28 T 13 R 174
 BOOK PAGE 23 LIST 28