


STATE OF KANSAS  
STATE CORPORATION COMMISSION

Give All Information Completely  
Make Required Affidavit  
Mail or Deliver Report to:  
Conservation Division  
State Corporation Commission  
800 Bittling Building  
Wichita, Kansas

04278  
15.051. ~~0277~~ 00.00  
WELL PLUGGING RECORD

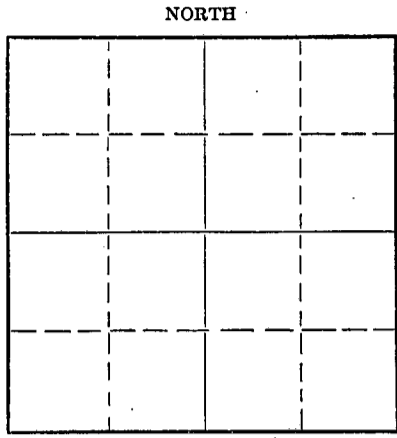

Ellis County. Sec. 28 Twp. 13S Rge. 17W (XXXXXXXXXX)  
Location as "NE/CNW $\frac{1}{4}$ SW $\frac{1}{4}$ " or footage from lines NE. SE. SE  
Lease Owner Brooks Pierce et al  
Lease Name Dreiling "A" Well No. 1  
Office Address 1208 Union National Bank Bldg., Wichita, Kansas  
Character of Well (completed as Oil, Gas or Dry Hole)  
Date well completed 19  
Application for plugging filed 19  
Application for plugging approved 19  
Plugging commenced December 10, 1952  
Plugging completed December 13, 1952  
Reason for abandonment of well or producing formation  
If a producing well is abandoned, date of last production 19  
Was permission obtained from the Conservation Division or its agents before plugging was commenced? Yes

Name of Conservation Agent who supervised plugging of this well Eldon Petty  
Producing formation Depth to top Bottom Total Depth of Well Feet  
Show depth and thickness of all water, oil and gas formations.

OIL, GAS OR WATER RECORDS CASING RECORD

Formation	Content	From	To	Size	Put In	Pulled Out
				5-1/2"	3478'	2991'
				8-5/8"	160'	None

Describe in detail the manner in which the well was plugged, indicating where the mud fluid was placed and the method or methods used in introducing it into the hole. If cement or other plugs were used, state the character of same and depth placed, from feet to feet for each plug set.

Pipe collapsed at 3000' and mud came in hole.  
Pumped in 25 sacks of mud and 50 sacks cement  
which filled to 4". Ran 1 sack of cement to  
fill to top. Plugging completed.

RECEIVED  
STATE CORPORATION COMMISSION  
1-6-53  
JAN 6 - 1953  
CONSERVATION DIVISION

Name of Plugging Contractor West Supply Company  
Address Chase, Kansas

STATE OF KANSAS, COUNTY OF SEDGWICK, ss.  
Brooks Pierce (employee of owner or (owner or operator) of the above-described well,  
being first duly sworn on oath, says: That I have knowledge of the facts, statements, and matters herein contained and the log of the above-described well as filed and that the same are true and correct. So help me God.

(Signature) Brooks Pierce  
1208 Union National Bank Bldg.  
Wichita, Kansas



SUBSCRIBED AND SWORN to before me this 5th day of January 1953.  
My commission expires September 8, 1954.

23-8390-s 6-51-20M

PLUGGING  
FILE SEC 28 T 13 R 17W  
BOOK PAGE 61 LINE 29

BROOKS PIERCE DRILLING COMPANY  
UNION NATIONAL BANK BUILDING  
WICHITA 2, KANSAS

DREILING NO. 1  
NE SE SE Sec. 28-13S-17W  
Ellis County, Kansas

<u>Formation</u>	<u>From</u>	<u>To</u>	<u>Remarks</u>
Clay	0	25	8-5/8" Surface Pipe @ 160', cemented with 100 sacks.
Sand	25	35	
Shale	35	70	
Shale & Shells	70	635	
Sand	635	800	
Shale & Red Bed	800	820	
Red Bed & Shale	820	1155	
Anhydrite	1155	1200	
Shale	1200	1320	
Red Bed, Shale and Shells	1320	1690	
Salt	1690	1710	
Salt & Shale	1710	1770	
Shale & Lime	1770	1835	
Lime	1835	1995	
Shale	1995	2020	
Lime & Shale	2020	2215	
Lime	2215-	2400	
Lime & Shale	2400	2450	
Shale & Sand	2450	2490	
Shale & Lime	2490	2530	
Broken Lime	2530	2600	
Shale & Lime	2600	2670	
Shale & Shells	2670	2810	
Sandy Lime & Shale	2810	2850	
Lime & Shale	2850	2895	
Shale & Shells	2895	3065	
Lime & Shale	3065	3090	
Cherty Lime	3090	3118	
Lime	3118	3485	
3485 Adjusted to		3483' TD	Set Casing.

15.051.04788.00.00

**PLUGGING**  
FILE SEC 28-13-S-17W  
BOOK PAGE 61 LINE 29

I hereby certify the foregoing to be a true and accurate Driller's Log of the formations encountered in the above well.

RECEIVED  
STATE CORPORATION COMMISSION  
JAN 6 - 1953  
CONCRETE DIVISION  
Wichita, Kansas

BROOKS PIERCE DRILLING COMPANY

By Brooks Pierce  
BROOKS PIERCE, OWNER

Subscribed and sworn to before me this 24th day of October, 1952.

My Commission expires Sept. 8, 1954.

Louise J. Dawson  
Notary Public

