

CARD MUST BE TYPED

State of Kansas
NOTICE OF INTENTION TO DRILL
(see rules on reverse side)

CARD MUST BE SIGNED

Starting Date: September 11 1985
month day year

API Number 15- 051-01,040-00-01
approx East
SE SE NE Sec 28 Twp 13 S, Rge 17 West
(location)

OPERATOR: License # 5145
Name Dreiling Oil, Inc.
Address Box 1000
City/State/Zip Victoria, KS 67671
Contact Person Bill Draper
Phone 913-735-2204

APPROX 2970... Ft North from Southeast Corner of Section
510... Ft West from Southeast Corner of Section
(Note: Locate well on Section Plat on reverse side)

CONTRACTOR: License # 5145
Name Dreiling Oil, Inc.
City/State Victoria, KS 67671

Nearest lease or unit boundary line 330 feet.
County Ellis

Lease Name Dreiling 'H' Well# 1 Twin

Well Drilled For: Well Class: Type Equipment:
 Oil Swd Infield Mud Rotary
 Gas Inj Pool Ext. Air Rotary
 OWWO Expl Wildcat Cable

Domestic well within 330 feet: yes no
Municipal well within one mile: yes no

If OWWO: old well info as follows:
Operator Dreiling Oil, Inc.
Well Name Dreiling 'H' #1
Comp Date 2-28-62 Old Total Depth 3555'
Projected Total Depth 3975 feet
Projected Formation at TD Granite Wash
Expected Producing Formations none

Depth to Bottom of fresh water 50 feet
Lowest usable water formation Dakota Sand

Depth to Bottom of usable water 425' 600 feet

Surface pipe by Alternate: 1 2
Surface pipe to be set 126' already set feet

Conductor pipe if any required 1955 feet
Ground surface elevation 1955 feet MSL

This Authorization Expires 2-28-86
Approved By 8-28-85


I certify that we will comply with K.S.A. 55-101, et seq., plus eventually plugging hole to K.C.C. specifications.
Date 8-27-85 Signature of Operator or Agent Bill Draper Title Drlg. Supt' casing will be cemented from Anhydrite up immediately following setting casing

Must be filed with the K.C.C. five (5) days prior to commencing well
This card void if drilling not started within six (6) months of date received by K.C.C.

RECEIVED
STATE CORPORATION COMMISSION
AUG 28 1985
CONSERVATION DIVISION
Wichita, Kansas

Important procedures to follow :

**A Regular Section of Land
1 Mile = 5,280 Ft.**

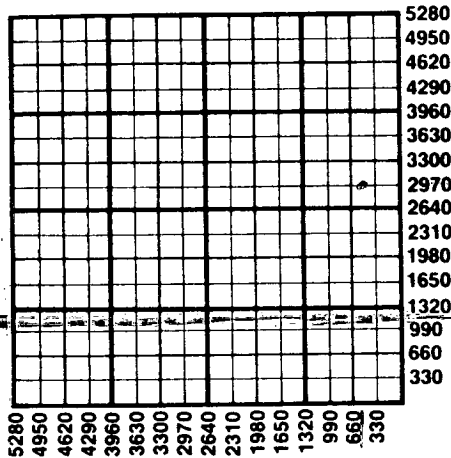

1. Notify District office before setting surface casing.
2. Set surface casing by circulating cement to the top.
3. File completion forms ACO-1 with K.C.C. within 90 days of well completion, following instructions on ACO-1, side 1, and including copies of wireline logs.
4. Notify District office 48 hours prior to old well workover or re-entry.
5. Prior to plugging, prepare a plugging plan, then obtain agreement from the appropriate district office for an approved plugging plan.
6. Submit plugging report (CP-4) to K.C.C. after plugging is completed.
7. Obtain an approved injection docket number before disposing of salt water.
8. Notify K.C.C. within 10 days when injection commences or terminates.
9. If an alternate 2 completion, cement in the production pipe from below any usable water to surface within 120 days of spud date.

State Corporation Commission of Kansas
Conservation Division
200 Colorado Derby Building
Wichita, Kansas 67202
(316) 263-3238