

15-195-21039-00-00

RECEIVED  
STATE CORPORATION COMMISSION

FORM CP-4

AUG 11 1982

STATE OF KANSAS  
STATE CORPORATION COMMISSION

WELL PLUGGING RECORD


CONSERVATION DIVISION  
Wichita, Kansas

Give All Information Completely  
Make Required Affidavit  
Mail or Deliver Report to  
Conservation Division  
State Corporation Comm.  
245 North Water  
Wichita, KS 67202

Trego County. Sec. 12 Twp. 13 Rge. 22 E/W  
Location as "NE/CNW $\frac{1}{4}$ SW $\frac{1}{4}$ " or footage from lines CSE-NE/SE

Lease Owner P. P. C. Industries  
Lease Name Tawney Well No. 1

Office Address P. O. Box 1400 N, Arvada, Colorado 80001  
Character of Well (Completed as Oil, Gas or Dry Hole) Completed as ~~oil~~ dry hole

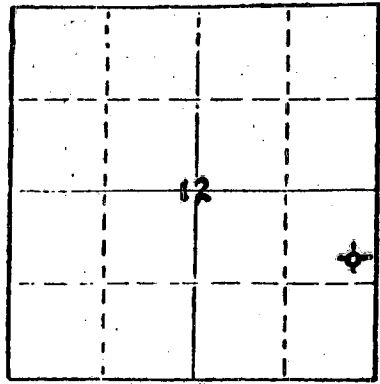

Locate well correctly on above  
Section Plot

Date Well completed August 2, 1982  
Application for plugging filed August 2, 1982  
Application for plugging approved August 2, 1982  
Plugging commenced August 2, 1982  
Plugging completed August 2, 1982  
Reason for abandonment of well or producing formation Dry

If a producing well is abandoned, date of last production N/A

Was permission obtained from the Conservation Division or its agents before plugging was commenced? Yes

Name of Conservation Agent who supervised plugging of this well Carl Goodrow  
Producing formation Cher. Depth to top 4008 Bottom 4021 Total Depth of Well 4022  
Show depth and thickness of all water, oil and gas formations.

OIL, GAS OR WATER RECORDS

CASING RECORD

FORMATION	CONTENT	FROM	TO	SIZE	PUT IN	PULLED OUT
Surface	Surface Pipe	Surface	258'	8 5/8"	258'	None
Long String	Long String	Surface	4022'	4 1/2"	4022'	3370'

Describe in detail the manner in which the well was plugged, indicating where the mud fluid was placed and the method or methods used in introducing it into the hold. If cement or other plugs were used, state the character of same and depth placed, from          feet to          feet for each plug set.

Mixed 4 sacks of cotton seed hulls and 36 sacks of gel. Followed with 80 sacks of cement (50-50 poz. 4% gel and 3% cal. chloride). Mixed 3 more sacks of gel and released 8 5/8" plug and pumped 70 more sacks of cement (50-50 poz. 4% gel and 3% cal. chloride) on top of plug.

(If additional description is necessary, use BACK of this sheet)

Name of Plugging Contractor Pfeifer Well Service, Inc.

STATE OF KANSAS COUNTY OF SEDGWICK, ss.  
DALE P. JEWETT, (CONSULTANT TO ~~owner~~ owner or operator)  
of the above-described well, being first duly sworn on oath, says: That I have knowledge of the facts, statements, and matters herein contained and the log of the above-described well as filed and that the same are true and correct. So help me God.

(Signature) [Signature]  
(Address)         

SUBSCRIBED AND SWORN TO before me this 10th day of August, 1982

[Signature]  
Toni K. Halstead Notary Public.

My commission expires June 17, 1985

