


15-195-21333-00-00

WELL PLUGGING RECORD

All information completely  
Required Affidavit  
or Deliver Report to  
Conservation Division  
State Corporation Comm.  
245 North Water  
Wichita, KS 67202

Trego County, Sec. 12 Twp. 13S R. 22W  
Location as "NE/4NW/4SW/4" or footage from lines  
C N/2 NE SE  
Lease Owner Wolf Petroleum  
Lease Name Tawney A Well No. 9-12  
Office Address Box 7202, Longview, Texas 75607  
Character of Well (Completed as Oil, Gas or Dry Hole)  
Dry Hole

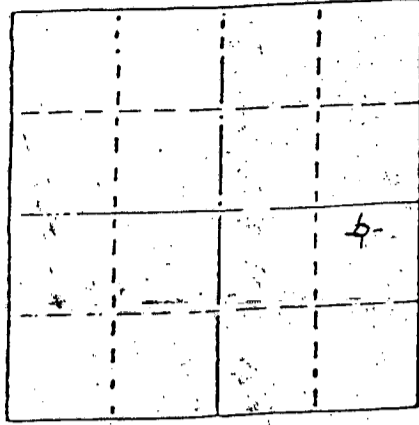

Date Well completed October 8, 1983 19  
Application for plugging filed October 8, 1983 19  
Application for plugging approved October 8, 1983 19  
Plugging commenced October 8, 1983 19  
Plugging completed October 8, 1983 19  
Reason for abandonment of well or producing formation  
Dry Hole

If a producing well is abandoned, date of last production  
N/A 19  
Was permission obtained from the Conservation Division or  
its agents before plugging was commenced? Yes

Name of Conservation Agent who supervised plugging of this well Gil Balthazor  
Producing formation Depth to top Bottom Total Depth of Well 4034  
Well depth and thickness of all water, oil and gas formations.

OIL, GAS OR WATER RECORDS

CASING RECORD

FORMATION	CONTENT	FROM	TO	SIZE	PUT IN	PULLED OUT
Sand				8 5/8"	252'	none

Describe in detail the manner in which the well was plugged, indicating where the mud was  
placed and the method or methods used in introducing it into the hole. If cement or other  
materials were used, state the character of same and depth placed, from \_\_\_\_\_  
feet to \_\_\_\_\_ feet for each plug set.

- 1750' 20 SX
- 800' 50 SX
- 260' 20 SX
- 40' 10 SX
- RH 10 SX

50 - 50 POZ 6% gel 3% ccl

(If additional description is necessary, use BACK of this sheet)

Name of Plugging Contractor Allied Cementing Co., Inc.

STATE OF TEXAS COUNTY OF Gregg, SB.  
William M Fisher (employee of owner) or (owner or operator)  
of the above-described well, being first duly sworn-on-oath, says: That I have knowledge of  
the facts, statements, and matters herein contained and the log of the above-described well  
is true and that the same are true and correct. So help me God.

(Signature) William M Fisher  
P.O. Box 7202 Longview TX 75607  
(Address)

SUBSCRIBED AND SWORN TO before me this 30th day of December, 1983

Notary Public.  
Walter E. Spangler  
RECEIVED  
JAN 03 1984  
158-03-10  
KANSAS STATE CORPORATION COMMISSION

Commission expires 11/30/87