


STATE OF KANSAS
STATE CORPORATION COMMISSION

WELL PLUGGING RECORD

Give All Information Completely
Make Required Affidavit
Mail or Deliver Report to
Conservation Division
State Corporation Comm.
245 North Water
Wichita, KS 67202

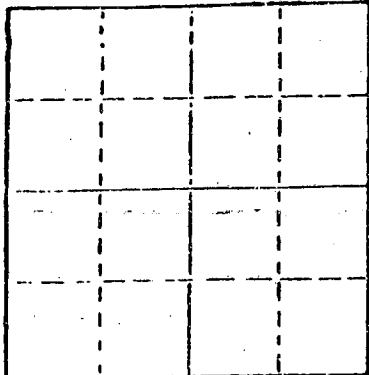

Locate well correctly on above Section Plot

Trego County. Sec. 9 Twp. 13S Rge. 22 E/W
Location as "NE/CNW $\frac{1}{4}$ SW $\frac{1}{4}$ " or footage from lines _____

SE SW NE
Lease Owner Rains & Williamson Oil Co., Inc.
Lease Name Novatne-Mai Well No. #1
Office Address 435 Page Court, 220 W. Douglas, Wichita, Ks.
Character of Well (Completed as Oil, Gas or Dry Hole) _____

Dry Hole
Date Well completed 2-11-81 19
Application for plugging filed 2-10-81 19
Application for plugging approved 2-10-81 19
Plugging commenced 2-10-81 19
Plugging completed 2-11-81 19

Reason for abandonment of well or producing formation _____
Commercial quantities of oil not found
If a producing well is abandoned, date of last production _____ 19

Was permission obtained from the Conservation Division or its agents before plugging was commenced? Yes

Name of Conservation Agent who supervised plugging of this well Gilbert Balthazor
Producing formation _____ Depth to top _____ Bottom _____ Total Depth of Well 4250'
Show depth and thickness of all water, oil and gas formations.

OIL, GAS OR WATER RECORDS

CASING RECORD

FORMATION	CONTENT	FROM	TO	SIZE	PUT IN	PULLED OUT
				8 5/8"	206'	None

Describe in detail the manner in which the well was plugged, indicating where the mud fluid was placed and the method or methods used in introducing it into the hold. If cement or other plugs were used, state the character of same and depth placed, from _____ feet to _____ feet for each plug set.

Plug @ 720' w/60 sx.
Plug @ 200' w/30 sx.
Plug @ 40' w/10 sx.
Rat Hole .5 sx.

*RWD
02-18-81*

(If additional description is necessary, use BACK of this sheet)


Name of Plugging Contractor Rains & Williamson Oil Co., Inc.

STATE OF Kansas COUNTY OF Sedgwick, ss.
Wilson Rains, President of Rains & Williamson Oil Co., Inc. (employee of owner) or (owner or operator) of the above-described well, being first duly sworn on oath, says: That I have knowledge of the facts, statements, and matters herein contained and the log of the above-described well as filed and that the same are true and correct. So help me God.

(Signature) Wilson Rains
435 Page Court, 220 W. Douglas, Wichita, Ks. 67202
(Address)

SUBSCRIBED AND SWORN TO before me this 17 day of February, 19 81

Juanita M. Green
Juanita M. Green Notary Public.

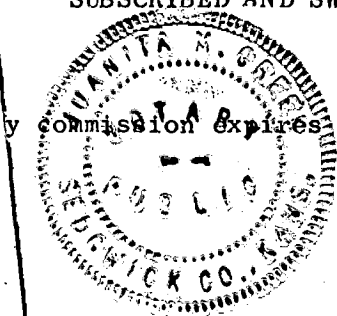

15-195-20662-00-00

DRILLER'S LOG

COMPANY: Rains & Williamson Oil Co., Inc. SEC. 9 T. 13S R. 22W

LOC. SE SW NE

WELL NAME: Novatne-Mai #1

COUNTY: Trego

RIG NO. #11

TOTAL DEPTH 4250'

ELEVATION 2310 GL 2315 KB

COMMENCED: 2-2-81 COMPLETED: 2-11-81

CONTRACTOR: Rains & Williamson Oil Co., Inc.

CASING RECORD:

SURFACE: 8 5/8" @ 206' w/165 sx. 60/40 poz., 2% gel, 3% cc.

PRODUCTION: D&A

LOG

(Figures Indicate Bottom of Formations)

Shale	1270
Sand	1492
Shale	3170
Shale & Lime	3740
Sand	4250
<u>ROTARY TOTAL DEPTH</u>	<u>4250</u>

RECEIVED
STATE CORPORATION COMMISSION

FEB 18 1981

CONSERVATION DIVISION
Wichita, Kansas

STATE OF Kansas)

COUNTY OF Sedgwick)

SS:

I, Wilson Rains, President of Rains & Williamson Oil Co., Inc.
upon oath state that the above and foregoing is a true and correct copy of the log of the
Novatne-Mai #1 well.

Wilson Rains
Wilson Rains

Subscribed and sworn to before me this 17 day of February, 1981.

My Appointment Expires:

10-4-83

Juanita M. Green
Juanita M. Green

