

15-195-00025-00-00

STATE OF KANSAS  
STATE CORPORATION COMMISSION

Give All Information Completely  
Make Required Affidavit  
Mail or Deliver Report to:  
Conservation Division  
State Corporation Commission  
800 Bitting Building  
Wichita, Kansas

WELL PLUGGING RECORD

Trego

County, Sec. 10 Twp. 13 Rge. 22 (E) W (W)

Location as "NE/CNW $\frac{1}{4}$ SW $\frac{1}{4}$ " or footage from lines C/SE $\frac{1}{4}$  NW $\frac{1}{4}$  SE $\frac{1}{4}$

Lease Owner Don E. Pratt

Lease Name Humburg Well No. 1

Office Address Hays, Kansas P. O. Box 656

Character of Well (completed as Oil, Gas or Dry Hole) Dry Hole

Date well completed 11-10-51 19

Application for plugging filed 11-10-51 19

Application for plugging approved 11-10-51 19


Plugging commenced 11-10-51 19

Plugging completed 11-10-51 19

Reason for abandonment of well or producing formation Dry Hole

If a producing well is abandoned, date of last production 19

Was permission obtained from the Conservation Division or its agents before plugging was commenced? Yes

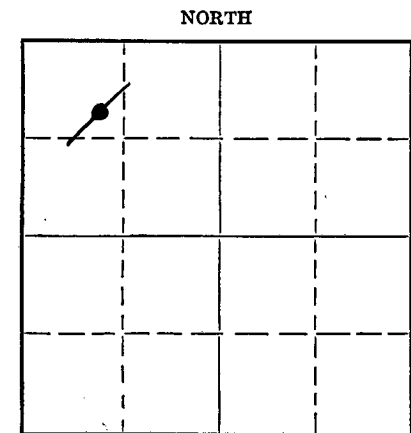

Locate well correctly on above Section Flat

Name of Conservation Agent who supervised plugging of this well Eldon R. Petty

Producing formation Depth to top Bottom Total Depth of Well 4101 Feet

Show depth and thickness of all water, oil and gas formations.

OIL, GAS OR WATER RECORDS

CASING RECORD

Formation	Content	From	To	Size	Put In	Pulled Out
		0	180'	8-5/8	180'	0

Describe in detail the manner in which the well was plugged, indicating where the mud fluid was placed and the method or methods used in introducing it into the hole. If cement or other plugs were used, state the character of same and depth placed, from 170' feet to 40' feet for each plug set.

First Plug @ 170' 1/2 Sack Hulls, 15 Sacks Cement Mud to 40' where second plug set, 1/2 Sack Hulls 10 Sacks Cement.

DEC 26 1951  
12-26-51  
Conservation Division  
Wichita, Kansas

(If additional description is necessary, use BACK of this sheet)

Correspondence regarding this well should be addressed to Don E. Pratt  
Address P. O. Box 656, Hays, Kansas

STATE OF Kansas, COUNTY OF Ellis, ss.  
Don E. Pratt (employee of owner) or (owner or operator) of the above-described well,

being first duly sworn on oath, says: That I have knowledge of the facts, statements, and matters herein contained and the log of the above-described well as filed and that the same are true and correct. So help me God.

(Signature) [Signature]

(Address)

SUBSCRIBED AND SWORN to before me this 10th day of November, 1951

[Signature]  
Notary Public

My commission expires October 1, 1955

PLUGGING  
FILE SEC 10 T 13 R 24  
BOOK PAGE 144 LINE 4

Well: Hamburg # 1.,  
 Location: SE NW SE -10-13-22W-Trego County  
 Company: Don E. Pratt, Oil Operator  
 Contractor: Overland Drilling Company  
 Commenced: 10-25-51  
 Completed: 11-10-51  
 Elevation: 2299  
 Total Depth: ~~4110~~ 4101

<u>Depth</u>	<u>Formation</u>	
0-180	Shale	
180-405	Shale	8-5/8" casing: Set @ 185'
405-460	Sand	
460-655	Shale	
655-925	Shale	
<del>925</del> 1390	Shale & Shells	Tops: Anhydrite: 1743
1390-1425	Sand	Heebner 3665
1425-1505	Red Shale	Kansas City 3699
1505-1743	Shale & Shells	Marmaton 4054-4075
1743-1787	Anhydrite	
1787-2045	Shale & Shells	
2045-2290	Shale & Shells	
2290-2465	Shale & Lime	
2465-2585	Shale & Lime	
2585-2590	Lime	
2590-2725	Lime	
2725-2750	Lime	
2750-2788	Shale	
2788-2865	Shale	
2865-2960	Shale	
2960-3000	Lime	
2000-3147	Lime	
3147-3319	Lime & Shale	
3319-3473	Shale, Lime & Mica	
3473-3582	Lime	
3582-3695--	Lime	
3695-3781	Lime	
3781-3888	Lime & Shale	
3880-3939	Lime	
3939-4037	Lime	
4027-4101	Lime	
4101- <del>4110</del>	Total Depth	

Now comes Don E. Pratt, who states that he is familiar with the drilling of oil and gas wells and knows of his own knowledge that the Hamburg No. 1 located in SE-NW SE-kO-13-22W, Trego County Kansas, was drilled to total depth of 4110 feet. Same was plugged and abandoned.

  
 Don E. Pratt.,

Subscribed and sworn to before me, a Notary Public, this 10th day of November, 1951.

Notary Public Velen Dinger

My commission expires: Oct. 1, 1955.,

**PLUGGING**  
 FILE SEC 107 13 R 220  
 BOOK PAGE 156 LINE 4