


15-167-21186.0000

STATE OF KANSAS
STATE CORPORATION COMMISSION

WELL PLUGGING RECORD

Give All Information Completely
Make Required Affidavit
Mail or Deliver Report to
Conservation Division
State Corporation Comm.
245 North Water
Wichita, KS 67202

Russell County, Sec. 6 Twp. 14S Rge. 12W E/W
Location as "NE/CNW $\frac{1}{4}$ SW $\frac{1}{4}$ " or footage from lines _____
C NE SW
Lease Owner Davies & Company, Inc.
Lease Name Paul Humes Well No. 1-6
Office Address 1304 Philtower Bldg., Tulsa, Oklahoma
Character of Well (Completed as Oil, Gas or Dry Hole) _____
Dry Hole
Date Well completed May 16 1978
Application for plugging filed May 16 1978
Application for plugging approved May 16 1978
Plugging commenced May 16 1978
Plugging completed May 16 1978
Reason for abandonment of well or producing formation _____
Dry Hole

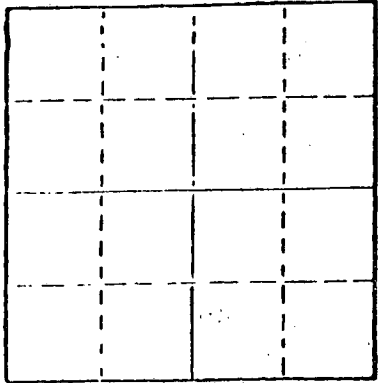

Locate well correctly on above
Section Plat

If a producing well is abandoned, date of last production _____ 19____
Was permission obtained from the Conservation Division or
its agents before plugging was commenced? Yes

Name of Conservation Agent who supervised plugging of this well Rankin
Producing formation _____ Depth to top _____ Bottom _____ Total Depth of Well 3385
Show depth and thickness of all water, oil and gas formations.

OIL, GAS OR WATER RECORDS

CASING RECORD

FORMATION	CONTENT	FROM	TO	SIZE	PUT IN	PULLED OUT
				8 5/8"	345'	-0-

Describe in detail the manner in which the well was plugged, indicating where the mud fluid
was placed and the method or methods used in introducing it into the hold. If cement or other
plugs were used, state the character of same and depth placed, from _____ feet to
_____ feet for each plug set.

Hole plugged with 40 sx @ 360',
20 sx @ 240', Bridge & plug @ 40'
with 10. sx, 2 sx in rathole.

RECEIVED
STATE CORPORATION COMMISSION
MAY 26 1978
05-26-78
CONSERVATION DIVISION
WICHITA, KANSAS

(If additional description is necessary, use BACK of this sheet)
Name of Plugging Contractor B & B DRILLING, INC.
515 Union Center, Wichita, Ks.

STATE OF KANSAS COUNTY OF SEDGWICK, ss.
Bill Lahar (employee of owner) or (owner or operator)
of the above-described well, being first duly sworn on oath, says: That I have knowledge of
the facts, statements, and matters herein contained and the log of the above-described well
as filed and that the same are true and correct. So help me God.

(Signature) Bill Lahar
515 Union Center, Wichita, Ks.
(Address)

SUBSCRIBED AND SWORN TO before me this 22 day of May, 1978

Betty M. Abbott
Betty M. Abbott Notary Public.

My commission expires January 22, 1979



May 22, 1978

DRILLERS LOG

#1-6 Paul Humes
C NE SW
Sec. 6-14S-12W
Russell County, Kansas

OPERATOR: Davies & Company, Inc.
CONTRACTOR: B & B Drilling, Inc.
COMMENCED: May 8, 1978
COMPLETED: May 16, 1978

RECEIVED
MAY 26 1978
CONSERVATION DIVISION

8 5/8" @ 345' w/180' sx

0	230	Surface soil
230	260	Sand
260	356	Shale
356	783	Shale, Shells & Sand
783	819	Anhydrite
819	2182	Shale
2182	2430	Lime & Shale
2430	2645	Shale
2645	2790	Lime
2790	2920	Shale & Lime
2920	3385	Lime
3385		RTD D & A


We certify that the above and foregoing is a true and correct copy of the log on the #1-6 Paul Humes, located in Russell County, Kansas.

B & B DRILLING, INC.

Bill Lahar

Bill Lahar

Subscribed and sworn to before me this 22nd day of May, 1978.

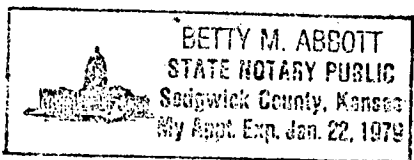

Betty M. Abbott
Betty M. Abbott Notary Public

My Commission Expires:

January 22, 1979