


STATE OF KANSAS
STATE CORPORATION COMMISSION

Give All Information Completely
Make Required Affidavit
Mail or Deliver Report to:
Conservation Division
State Corporation Commission
800 Bittling Building
Wichita, Kansas

WELL PLUGGING RECORD

15-195-00161-00-00

NORTH

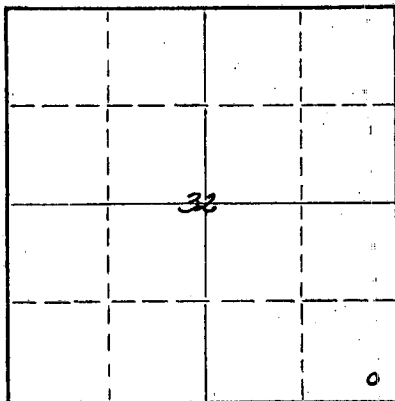

Locate well correctly on above
Section Plat

Trego County. Sec. 32 Twp. 13S Rge. 22 (XX) (W)
Location as "NE/CNW/SW" or footage from lines SE/4 SE/4 SE/4
Lease Owner Anschutz Drilling Co., Inc.
Lease Name Mulheim Well No. One
Office Address 1411 Mile High Center, Denver, Colorado
Character of Well (completed as Oil, Gas or Dry Hole) Dry Hole
Date well completed January 6, 19 56
Application for plugging filed January 6, 19 56
Application for plugging approved January 6, 19 56
Plugging commenced January 6, 19 56
Plugging completed January 6, 19 56
Reason for abandonment of well or producing formation Dry Hole

If a producing well is abandoned, date of last production 19
Was permission obtained from the Conservation Division or its agents before plugging was commenced? yes

Name of Conservation Agent who supervised plugging of this well Eldon Petty, Box 326, Hays, Kansas
Producing formation Depth to top Bottom Total Depth of Well 4550 Feet
Show depth and thickness of all water, oil and gas formations.

OIL, GAS OR WATER RECORDS

CASING RECORD

FORMATION	CONTENT	FROM	TO	SIZE	PUT IN	PULLED OUT
				8 5/8"	233'	

Describe in detail the manner in which the well was plugged, indicating where the mud fluid was placed and the method or methods used in introducing it into the hole. If cement or other plugs were used, state the character of same and depth placed, from feet to feet for each plug set.

Plugging:

Filled hole to 230' - put some hulls in sacks ahead of plug and pushed to 230' cemented with 15 sacks cement. Filled hole to 40' - put some hulls in sacks ahead of plug - pushed to 40' - cemented with 10 sacks cement to bottom of cellar.

(If additional description is necessary, use BACK of this sheet)
Name of Plugging Contractor Anschutz Drilling Co., Inc.
Address 1411 Mile High Center, Denver, Colorado

STATE OF Colorado, COUNTY OF Denver, ss.
E. G. Koelling (employee of owner) or (owner or operator) of the above-described well, being first duly sworn on oath, says: That I have knowledge of the facts, statements, and matters herein contained and the log of the above-described well as filed and that the same are true and correct. So help me God.

(Signature) E. G. Koelling
1411 Mile High Center, Denver, Colorado
(Address)


SUBSCRIBED AND SWORN TO before me this 13th day of January, 19 56



October 4, 1959

James M. Robertson
Notary Public.

RECEIVED
STATE CORPORATION COMMISSION

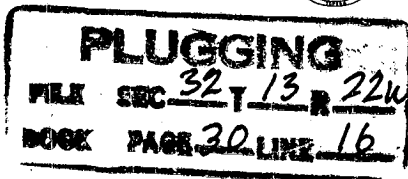

JAN 19 1956
01-19-56

Wichita, Kansas

15-195-00161-00-00

DRILLER'S LOG

Anschutz Drilling Co., Inc.
No. 1 Mulheim
SE SE SE Sec. 32-13S-22W
Trego County, Kans.

COMMENCED: December 18, 1955

COMPLETED: January 6, 1956

<u>FROM</u>	<u>TO</u>	
0	120	Surface clay, sand & shale
120	240	Shale & shells
240	1206	Shale
1206	1350	Shale & shells
1350	1555	Dakota sand
1555	1730	Shale & red bed
1730	1840	Shale & red bed
1840	1880	Anhydrite
1880	2015	Lime & shale
2015	2100	Lime & shale
2100	2185	Salt, shale & shells
2185	2310	Shale, shells & salt
2310	2385	Salt & shale streaks
2385	2440	Shale & lime streaks
2440	2580	Lime
2580	2675	Lime with shale streaks
2675	2725	Lime
2725	2780	Lime & shale
2780	2830	Lime
2830	2990	Lime & shale
2990	3055	Shale & lime
3055	3148	Lime & shale
3148	3205	Shale & lime
3205	3328	Lime & shale
3328	3375	Shale & lime
3375	3583	Lime & shale
3583	3653	Shale & lime
3653	3706	Lime & shale
3706	3770	Shale & lime
3770	3975	Lime
3975	4025	Lime with shale streaks
4025	4130	Lime & shale (4055 - limed shale)
4130	4140	sticky shale
4140	4160	Shale & lime
4160	4231	Lime
4231	4268	Lime & shale streaks
4268	4304	Lime
4304	4350	Sand, shale & lime
4350	4384	Cherty lime
4384	4445	Lime & shale
4445	4470	Cherty lime
4470	4550	Lime
	4550	ROTARY TOTAL DEPTH

CASING REPORT

Set 233' 8 5/8" casing with
175 sacks cement

D & A

STATE OF COLORADO)
CITY AND COUNTY OF DENVER) SS

I hereby affirm that the above and foregoing is a true and correct copy of the log of the No. 1 Mulheim located SE SE SE Sec. 32-13S-22W, Trego County, Kansas

PLUGGING

FILE SEC 32 T 13 R 22W
PAGE 30 LINE 16

ANSCHUTZ DRILLING CO., INC.

By:

E. G. Koelling

Subscribed and sworn to before me this 12th day of January, 1956.

Notary Public

My Commission Expires: October 4, 1959