STATE OF KANSAS
STATE CORPORATION COMMISSION


FORM CP-4

WELL PLUGGING RECORD 15-195-21100-00-00

Give All Information Completely
Make Required Affidavit
Mail or Deliver Report to
Conservation Division
State Corporation Comm.
200 Colorado Derby Bldg.
202 W. 1st St.
Wichita, KS 67202

Trego County Sec. 13 Twp. 13s Rge. 23 XX W
Location as "NE/CNW/SW" or footage from lines
C n/2 NE NE/4

Lease Owner Mark 111 Oil Inc.
Lease Name Janice Bradshaw Well No. 1
Office Address 211 W. 36th Hays, Kansas 67601
Character of Well (Completed as Oil, Gas or Dry Hole)
Dry Hole
Date Well completed November 2 19 82
Application for plugging filed November 2 19 82
Application for plugging approved November 2 19 82
Plugging commenced 4:30A.M. 11-2 19 82
Plugging completed 6:30A.M. 11-2 19 82
Reason for abandonment of well or producing formation
No Commercial Production
If a producing well is abandoned, date of last production
19
Was permission obtained from the Conservation Division or its agents before plugging was commenced? Yes

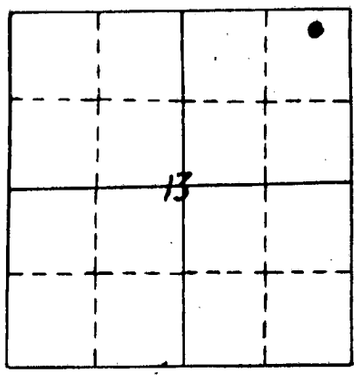

locate well correctly
on above
Section Plot

Name of Conservation Agent who supervised plugging of this well Gil Balthazor
Producing formation Depth to top Bottom Tl. Depth of Well
Show depth and thickness of all water, oil and gas formations.

OIL, GAS OR WATER RECORDS — CASING RECORD

FORMATION	CONTENT	FROM	TO	SIZE	PUT IN	PULLED OUT
Surface Casing	60-40-poz	0'	298.94	8 5/8"	298.94	0'

Describe in detail the manner in which the well was plugged, indicating where the mud fluid was placed and the method or methods used in introducing it into the hold. If cement or other plugs were used, state the character of same and depth placed, from feet to feet for each plug set.

RECEIVED
STATE CORPORATION COMMISSION
NOV 15 1982
11-15-82
CONSERVATION DIVISION
Wichita, Kansas

Plug #1 1880' with 20 sxs
Plug #2 1000' with 100 sxs
Plug #3 310' with 40 sxs
Plug #4 40' with 10 sxs
10 sxs in rathole
TOTAL----------180 sxs 50-50 poz 6%gel 3%cc

P.D. @ 6:30 A.M 11-2-82

(If additional description is necessary, use BACK of this sheet)

Name of Plugging Contractor Pioneer Drilling Co.

STATE OF Kansas COUNTY OF Ellis, ss.

D. J. Markley (employee of owner) or (owner or operator) of the above described well, being first duly sworn on oath, says: That I have knowledge of the facts, statements, and matters herein contained and the log of the above described well is filed and that the same are true and correct. So help me God.

SUSAN MARTENS
NOTARY PUBLIC
STATE OF KANSAS
MY APPT. EXPIRES 2-4-86

(Signature) D J Markley

(Address)

SUBSCRIBED AND SWORN TO before me this 10 day of November, 1982

My commission expires February 4, 1986

Susan Martens
Notary Public