

CARD MUST BE TYPED

State of Kansas

CARD MUST BE SIGNED

NOTICE OF INTENTION TO DRILL

(see rules on reverse side)

Expected Spud Date. April 28, 1988
month day yearAPI Number 15—063-21,197-00-00

OPERATOR: License # #5663
 Name Hess Oil Company
 Address P.O. Box 905
 City/State/Zip McPherson, Ks. 67460
 Contact Person Jamie Hess
 Phone (316) 263-2243

CONTRACTOR: License # #4958
 Name Mallard JV, Inc.
 City/State McPherson, Ks.

Well Drilled For: Well Class: Type Equipment:
☒ Oil ☐ Storage ☐ Infield ☒ Mud Rotary
☐ Gas ☐ Inj ☐ Pool Ext. ☐ Air Rotary
☐ OWWO ☐ Expl ☒ Wildcat ☐ Cable

If OWWO: old well info as follows:

Operator
 Well Name
 Comp Date Old Total Depth

I certify that well will comply with K.S.A. 55-101, et seq., plus eventually plugging hole to KCC specifications.

Date 4-25-88 Signature of Operator or Agent Jamie Hess Title Geologist

For KCC Use:

Conductor Pipe Required feet; Minimum Surface Pipe Required 200 feet per Alt. X 2This Authorization Expires 10-25-88 Approved By PCH 4-25-88EFFECTIVE DATE: 4-30-88

SW SE NE Sec. 8 Twp. 13S S, Rg. 30W
2970' Ft. from South Line of Section
990' Ft. from East Line of Section

(Note: Locate well on Section Plat on reverse side)


Nearest lease or unit boundary line 990 feetCounty GoveLease Name Ottley Well # 1Ground surface elevation 2838 feet MSLDomestic well within 330 feet: ☐ yes ☒ noMunicipal well within one mile: ☐ yes ☒ noDepth to bottom of fresh water 600' 150Depth to bottom of usable water 800'Surface pipe by Alternate: ☐ 1 ☒ 2Surface pipe planned to be set 200'Conductor pipe required noneProjected Total Depth 4800' feetFormation Lansing

Must be filed with the K.C.C. five (5) days prior to commencing well
This card void if drilling not started within six (6) months of date received by K.C.C.

Important procedures to follow:

1. Notify District office before setting surface casing.
2. Set surface casing by circulating cement to the top.
3. File completion forms ACO-1 with K.C.C. within 120 days of well spud date, following instructions on ACO-1, side 1, and including copies of wireline logs.
4. Notify District office 48 hours prior to old well workover or re-entry.
5. Prior to filing Intent, prepare a proposed plugging plan in case well is D & A, then obtain approval of plan when calling district office prior to setting surface pipe.
6. Submit plugging report (CP-4) to K.C.C. after plugging is completed.
7. Obtain an approved injection docket number before disposing of salt water.
8. Notify K.C.C. within 10 days when injection commences or terminates.
9. If an alternate 2 completion, cement in the production pipe from below any usable water to surface within 120 days of spud date.

A Regular Section of Land 1 Mile = 5,280 Ft.

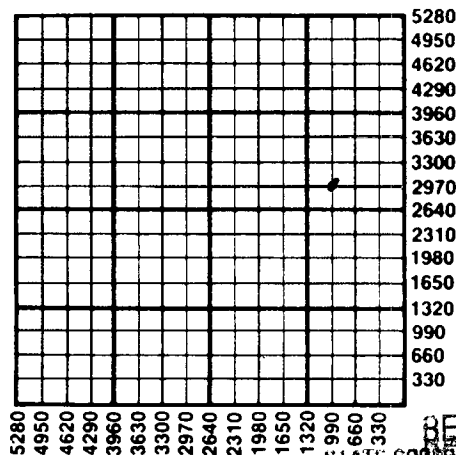

RECEIVED
STATE CORPORATION COMMISSION
APR 25 1988
04-25-1988
CONSERVATION DIVISION
Wichita, Kansas

State Corporation Commission of Kansas
Conservation Division
200 Colorado Derby Building
Wichita, Kansas 67202-1212
(316) 263-3238