

CARD MUST BE TYPED

State of Kansas

CARD MUST BE SIGNED

NOTICE OF INTENTION TO DRILL * CORRECTED Lease Name

(see rules on reverse side)

WAS: mendenhall

Starting Date 7 6 88 month day year

API Number 15-063-21, 210-00-00 ✓ D+A

OPERATOR: License # 5422
Name Abercrombie Drilling, Inc. & Robt. H. Hyde
Address 801 Union Center
City/State/Zip Wichita, KS 67202
Contact Person Jack Partridge
Phone 262-1841

SW NE SW Sec. 20 Twp. 13 S, Rg. 28
1800' East
3880' West

(Note: Locate well on Section Plat on reverse side)

CONTRACTOR: License # 5422
Name Abercrombie Drilling, Inc.
City/State Wichita, KS

Nearest lease or unit boundary line 1400' feet
County Gove
* Lease Name Mendenhall Well #1

Well Drilled For: Well Class: Type Equipment:
[X] Oil SWD Infield [X] Mud Rotary
Gas Inj Pool Ext Air Rotary
OWWO Expl [X] Wildcat Cable

Ground surface elevation feet MSL
Domestic well within 330 feet: yes [X] no
Municipal well within one mile: yes [X] no
Surface pipe by Alternate: 1 2 [X]
Depth to bottom of fresh water 120'
Depth to bottom of usable water 900' 1200'
Surface pipe planned to be set 200+
Projected Total Depth 4750' feet
Formation Arbuckle

If OWWO: old well info as follows:

Operator N/A
Well Name
Comp Date Old Total Depth

I certify that well will comply with K.S.A. 55-101, et seq., plus eventually plugging hole to KCC specifications.

cementing will be done immediately upon setting production casing
Date 7-6-88 Signature of Operator or Agent Jack Partridge Title

For KCC Use:


Conductor Pipe Required feet; Minimum Surface Pipe Required 200 feet per Alt.
This Authorization Expires 1-6-89 EFFECTIVE 7-11-88 Approved By RCH 7-6-88 CORRECTED 7-7-88

Must be filed with the K.C.C. five (5) days prior to commencing well
This card void if drilling not started within six (6) months of date received by K.C.C.

Important procedures to follow:

1. Notify District office before setting surface casing.
2. Set surface casing by circulating cement to the top.
3. File completion forms ACO-1 with K.C.C. within 90 days of well completion, following instructions on ACO-1, side 1, and including copies of wireline logs.
4. Notify District office 48 hours prior to old well workover or re-entry.
5. Prior to filing Intent, prepare a proposed plugging plan in case well is D & A, then obtain approval of plan when calling district office prior to setting surface pipe.
6. Submit plugging report (CP-4) to K.C.C. after plugging is completed.
7. Obtain an approved injection docket number before disposing of salt water.

**A Regular Section of Land
1 Mile = 5,280 Ft.**

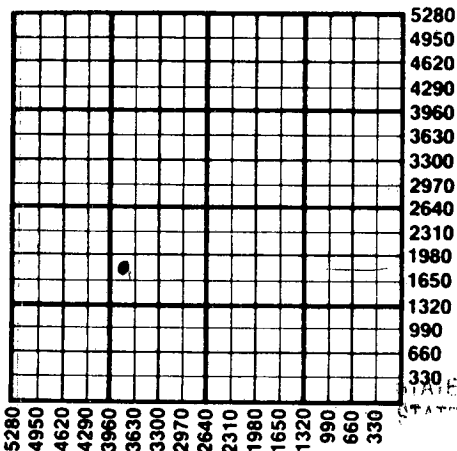

RECEIVED

STATE CORPORATION COMMISSION

STATE CORPORATION COMMISSION

Notify K.C.C. within 10 days when injection commences or terminates

9. If an alternate 2 completion, cement in the production pipe from below any usable water to surface within 120 days of spud date.

III 6 1988
07-06-88
CONSERVATION DIVISION
Wichita, Kansas

State Corporation Commission of Kansas
Conservation Division
200 Colorado Derby Building
Wichita, Kansas 67202
(316) 263-3238