


STATE OF KANSAS
STATE CORPORATION COMMISSION

WELL PLUGGING RECORD

Give All Information Completely
Make Required Affidavit
Mail or Deliver Report to:
Conservation Division
State Corporation Commission
211 No. Broadway
Wichita, Kansas

Gove County, Sec. 28 Twp. 13S Rge. 31W (E) (W)

NORTH

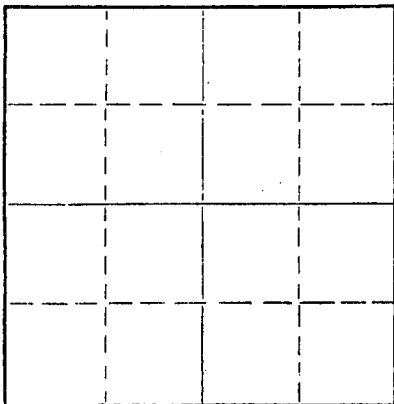

Locate well correctly on above
Section Plat

Location as "NE/CNW%SW%" or footage from lines SW SW
Lease Owner Thunderbird Drilling, Inc.
Lease Name Phelps "B" Well No. 1
Office Address P.O. Box 18407- Wichita, Ks. 67218
Character of Well (completed as Oil, Gas or Dry Hole) Dry Hole
Date well completed 7-9-79 19
Application for plugging filed 7-9-79 19
Application for plugging approved 7-9-79 19
Plugging commenced 7-9-79 19
Plugging completed 7-9-79 19
Reason for abandonment of well or producing formation Dry Hole

If a producing well is abandoned, date of last production 19
Was permission obtained from the Conservation Division or its agents before plugging was commenced? Yes

Name of Conservation Agent who supervised plugging of this well Gilbert Balthazor
Producing formation _____ Depth to top _____ Bottom _____ Total Depth of Well 4615 Feet
Show depth and thickness of all water, oil and gas formations.

OIL, GAS OR WATER RECORDS

CASING RECORD

FORMATION	CONTENT	FROM	TO	SIZE	PUT IN	PULLED OUT
				8 5/8"	316'	None

Describe in detail the manner in which the well was plugged, indicating where the mud fluid was placed and the method or methods used in introducing it into the hole. If cement or other plugs were used, state the character of same and depth placed, from _____ feet to _____ feet for each plug set.

1st plug @ 1250' w/70 sx
2nd plug @ 300' w/20 sx
3rd plug @ 40' w/10 sx

RECEIVED
STATE CORPORATION COMMISSION
JUL 23 1979
07-23-79
CONSERVATION DIVISION
Wichita, Kansas

(If additional description is necessary, use BACK of this sheet)
Name of Plugging Contractor Thunderbird Drilling, Inc.
Address P.O. Box 18407- Wichita, Kansas 67218

STATE OF KANSAS, COUNTY OF SEDGWICK, ss.
Burke Krueger (employee of owner) or (owner or operator) of the above-described

well, being first duly sworn on oath, says: That I have knowledge of the facts, statements, and matters herein contained and the log of the above-described well as filed and that the same are true and correct. So help me God.

(Signature) Burke Krueger
P.O. Box 18407- Wichita, Ks. 67218
(Address)

SUBSCRIBED AND SWORN TO before me this 19th day of July, 1979

My commission expires 3-25-80
Gloria DeJesus Notary Public.



DRILLERS LOG

Company Thunderbird Drilling, Inc.

Contractor Thunderbird Drilling, Inc

Elevation 2885' K.B.

Farm Phelps "B"

Well No. 1

Casing 8 5/8" @ 316' w/250 sx

Location SW SW

County Gove

Production

<u>From</u>	<u>To</u>	<u>Description</u>
0	316	Surface Hole
316	1670	Shale
1670	1693	Sand
1693	1989	Shale
1989	2003	Hard Sand
2003	2025	Shale
2025	2355	Shale w/snd strks
2355	2366	Shale & Red bed
2366	2406	Anhydrite
2406	2745	Shale
2745	3260	Shale & Lime
3260	3385	Lime & Shale
3385	3765	Shale & Lime
3765	3975	Lime & Shale
3975	4615	Lime
4615	T.D.	

RECEIVED
STATE CORPORATION COMMISSION

JUL 23 1979

CONSERVATION DIVISION
Wichita, Kansas

STATE OF KANSAS)
) ss.
COUNTY OF SEDGWICK)

I, Burke Krueger, of Thunderbird Drilling, Inc. upon oath states that the above and foregoing is a true and correct copy from the Daily Drilling Report from your Phelps "B" #1.

Burke Krueger

Subscribed and sworn to before me this 19th day of July, 19 79

Gloria DeJesus
Gloria DeJesus Notary Public

My commission expires: 3-25-80

GLORIA DeJESUS
Sedgwick County, Ks.
My Appt. Exp. 3-25-80