


Give All Information Completely  
Make Required Affidavit  
Mail or Deliver Report to:  
Conservation Division  
State Corporation Commission  
212 North Market, Insurance Bldg.  
Wichita, Kansas

15-109-00034-00-00

WELL PLUGGING RECORD

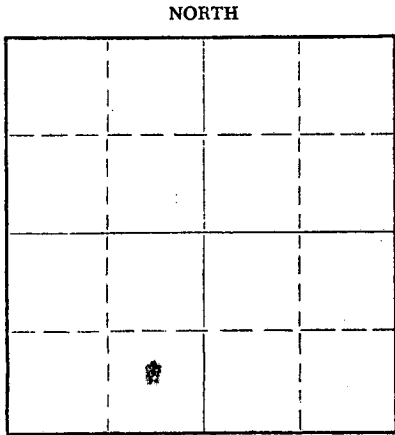

Locate well correctly on above Section Plat

Logan County. Sec. 19 Twp. 13S Rge. 33d (~~EXX~~) (W)  
Location as "NE/CNW/SW" or footage from lines SE SW  
Lease Owner Arvel C. Smith  
Lease Name Hieland Well No. 1  
Office Address 569 Stratford Road, Wichita 6, Kansas  
Character of Well (completed as Oil, Gas or Dry Hole) Dry Hole  
Date well completed March 8, 19 62  
Application for plugging filed March 8, 19 62  
Application for plugging approved March 8, 19 62  
Plugging commenced March 8, 19 62  
Plugging completed March 8, 19 62  
Reason for abandonment of well or producing formation Dry Hole

If a producing well is abandoned, date of last production \_\_\_\_\_ 19\_\_\_\_  
Was permission obtained from the Conservation Division or its agents before plugging was commenced? Yes

Name of Conservation Agent who supervised plugging of this well Mr. Eldon Petty  
Producing formation \_\_\_\_\_ Depth to top \_\_\_\_\_ Bottom \_\_\_\_\_ Total Depth of Well 4644 Feet  
Show depth and thickness of all water, oil and gas formations.

OIL, GAS OR WATER RECORDS				CASING RECORD		
FORMATION	CONTENT	FROM	TO	SIZE	PUT IN	PULLED OUT
	<u>8 5/8" Surface Pipe</u>	<u>0</u>	<u>202'</u>			<u>No</u>

Describe in detail the manner in which the well was plugged, indicating where the mud fluid was placed and the method or methods used in introducing it into the hole. If cement or other plugs were used, state the character of same and depth placed, from \_\_\_\_\_ feet to \_\_\_\_\_ feet for each plug set.

0 to 15' ---- 5 sack Cement Plug  
15' to 157' --- Heavy Mud  
157' to 202' --- 15 sack Cement Plug  
202' to 1060' -- Heavy Mud  
1060' to 1243' -- 60 sack Cement Plug  
1243' to T.D. --- Heavy Mud

RECEIVED  
STATE CORPORATION COMMISSION

MAR 14 1962  
03-14-1962  
CONSERVATION DIVISION  
Wichita, Kansas


(If additional description is necessary, use BACK of this sheet)  
Name of Plugging Contractor Natural Gas Drilling, Inc.,  
Address P. O. Box 1615, Oklahoma City, Oklahoma

STATE OF Kansas, COUNTY OF Sedgwick, ss.  
Arvel C. Smith (employee or owner or operator) of the above-described well, being first duly sworn on oath, says: That I have knowledge of the facts, statements, and matters herein contained and the log of the above-described well as filed and that the same are true and correct. So help me God.

(Signature) Arvel C. Smith

(Address) \_\_\_\_\_

SUBSCRIBED AND SWORN TO before me this 12th day of March, 19 62

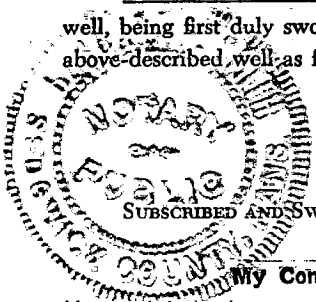

My Commission Expires Nov. 12, 1965  
Barbara F. Smith Notary Public.