

CARD MUST BE TYPED

State of Kansas

CARD MUST BE SIGNED

NOTICE OF INTENTION TO DRILL

(see rules on reverse side)

Starting Date March 15 1987
month day year

API Number 15— 109-20, 437-00-00

OPERATOR: License # 5181
Name SLAWSON, DONALD C.
Address 200 Douglas Building
City/State/Zip Wichita, Kansas 67202
Contact Person Bill Horigan
Phone (316) 263-3201

NE NE SW Sec. 23 Twp. 13 S, Rg. 33 East
..... X West
..... 2280' Ft. from South Line of Section
..... 2930' Ft. from East Line of Section

(Note: Locate well on Section Plat on reverse side)

CONTRACTOR: License # 5657
Name Slawson Drlg. Co.
City/State Wichita, Kansas

Nearest lease or unit boundary line 330' feet
County Logan

Well Drilled For: Well Class: Type Equipment:
 Oil SWD Infield Mud Rotary
 Gas Inj Pool Ext. Air Rotary
 OWWO Expl Wildcat Cable

Lease Name. STOLL 'T' Well # 1
Ground surface elevation .. 2969' GR. (L&S) feet MSL
Domestic well within 330 feet: yes no

If OWWO: old well info as follows:

Municipal well within one mile: yes no
Depth to bottom of fresh water 340'
Depth to bottom of usable water 1360'
Surface pipe by Alternate: 1 2
Surface pipe planned to be set 360'
Conductor pipe required
Projected Total Depth 4700' feet
Formation Mississippian

Operator
Well Name
Comp Date Old Total Depth

I certify that well will comply with K.S.A. 55-101, et seq., plus eventually plugging hole to KCC specifications. Western Kansas
Date 3/3/87 Signature of Operator or Agent Robert B. Jenkins Title District Geologist

For KCC Use:

Conductor Pipe Required 360 feet; Minimum Surface Pipe Required 360 feet per Alt. 40
This Authorization Expires 9-3-87 Approved By 3-3-87


Handwritten signature

Must be filed with the K.C.C. five (5) days prior to commencing well
This card void if drilling not started within six (6) months of date received by K.C.C.

Important procedures to follow:

1. Notify District office before setting surface casing.
2. Set surface casing by circulating cement to the top.
3. File completion forms ACO-1 with K.C.C. within 90 days of well completion, following instructions on ACO-1, side 1, and including copies of wireline logs.
4. Notify District office 48 hours prior to old well workover or re-entry.
5. Prior to filing Intent, prepare a proposed plugging plan in case well is D & A, then obtain approval of plan when calling district office prior to setting surface pipe.
6. Submit plugging report (CP-4) to K.C.C. after plugging is completed.
7. Obtain an approved injection docket number before disposing of salt water.
8. Notify K.C.C. within 10 days when injection commences or terminates.

**A Regular Section of Land
1 Mile = 5,280 Ft.**

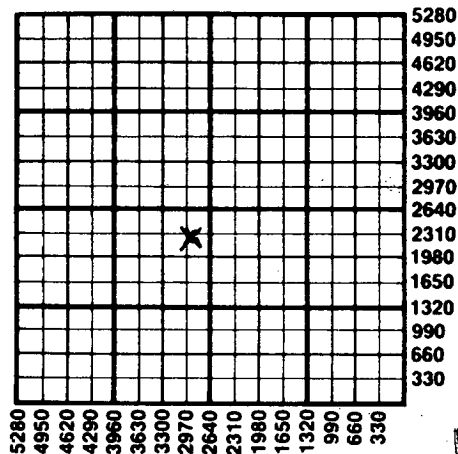

RECEIVED
STATE CORPORATION COMMISSION

MAR 3 1987
03-03-1987
CONSERVATION DIVISION
Wichita, Kansas

9. If an alternate 2 completion, cement in the production pipe from
SSDN any usable water to surface within 120 days of spud date.

State Corporation Commission of Kansas
Conservation Division
200 Colorado Derby Building
Wichita, Kansas 67202
(316) 263-3238