

FOR KCC USE:

FORM C-1 7/91

State of Kansas

15-109-20598-0000

FORM MUST BE TYPED

NOTICE OF INTENTION TO DRILL

FORM MUST BE SIGNED

EFFECTIVE DATE

10-28-95

DISTRICT# 4

Must be approved by the K.C.C. five (5) days prior to commencing well

ALL BLANKS MUST BE FILLED

SGA?...Yes...No

Spot 80 E OF

EAST

EXPECTED SPUD DATE: 10 23 95
month day year

ARR C NW NW NW Sec 05 Twp 13 S, Rg 33 WW WEST

330-330 feet from South / (North) Line of Section

410-4870 feet from East / (West) Line of Section

Operator: License#: 3966

IS SECTION XX REGULAR IRREGULAR?

Name: WANKER OIL

NOTE: Locate well on the Section Plat on Reverse Side)

Address: RR 2 BOX 14

COUNTY: LOGAN

City/State/Zip: WAKEENEY KS. 67672

LEASE NAME: JACK D. LEE WELL#: 3

Contact Person: PATRICK WANKER

Phone: 913-743-2769

Field Name:

Is this a Prorated/Spaced Field? yes XX no

CONTRACTOR: License # 05422

Target Formation(s): LNSNG KC & JOHNSON

Name: AMBERCROMBIE DRILLING, INC.

Nearest lease or unit boundary: 330

Ground Surface Elevation: 3005 EST feet MSL

Water well within one-quarter mile: yes XX no

Public water supply well within one mile: yes XX no

Depth to bottom of fresh water: 1230 180'

Depth to bottom of usable water: 1480 1500'

Surface Pipe by Alternate: 1 XX 2

Length of Surface Pipe Planned to be set: 200

Length of Conductor Pipe required: NONE

Projected Total Depth: 4675

Formation at Total Depth: MISSISSIPPI

Water Source for Drilling Operations:

XX well farm pond other

DWR Permit# APPL'D FOR

Will Cores Be Taken? yes XX no

If yes, proposed zone:

If OWWO: old well information as follows:

Operator:

Well Name:

Comp. Date: Old Total Depth

Directional, Deviated or Horizontal wellbore? yes XX no

If yes, true vertical depth:

Bottom Hole Location

AFFIDAVIT

RECEIVED

KANSAS CORPORATION COMMISSION

The undersigned hereby affirms that the drilling, completion and eventual plugging of this well will comply with K.S.A. 55-101 et. seq.

It is agreed that the following minimum requirements will be met:

OCT 23 1995

10-23-1995

1. Notify the appropriate district office prior to spudding of well.
2. A copy of the approved notice of intent to drill shall be posted on each drilling rig;
3. The minimum amount of surface pipe as specified below shall be set by circulating cement to the completion and in all cases surface pipe shall be set through all unconsolidated materials plus a minimum of 20 feet into the underlying formation
4. If the well is dry hole, an agreement between the operator and district office on plug length and placement is necessary prior to plugging;
5. The appropriate district office will be notified before well is either plugged or production casing is cemented in;
6. IF AN ALTERNATE II COMPLETION, PRODUCTION PIPE SHALL BE CEMENTED FROM BELOW ANY USABLE WATER TO SURFACE WITHIN (120) DAYS OF SPUD DATE. IN ALL CASES, NOTIFY DISTRICT OFFICE PRIOR TO ANY CEMENTING.

I hereby certify that the statements made herein are true and to the best of my knowledge and belief.

Date: 10/23/95

Signature of Operator or Agent: *Janna M. Eds*

Title

AGENT

SEARCH INC., 316-265-5415

1495

FOR KCC USE:

API # 15- 109-205980000

Conductor Pipe required NONE feet

Minimum surface pipe required 200 feet per Alt. X (2)

Approved by: JK 10-23-95

This Authorization expires: 4-23-96

(This authorization void if drilling not started within 6 months of effective date.)

Spud date: Agent:

REMEMBER TO:

- File Drill Pit Application (form CDP-1) with intent to Drill;
- File Completion Form ACO-1 within 120 days of spud date;
- File acreage attribution plat according to field proration orders;
- Notify appropriate district office 48 hour prior to workover or re-entry;
- Submit plugging report (CP-4) after plugging is completed;
- Obtain written approval before disposing or injecting salt water.

Mail to: KCC Conservation Office, Wichita State Office Building, 130 S. Market, Room 2078 Wichita, Ks 67202

5
13
3304

IN ALL CASES PLOT THE INTENDED WELL ON THE PLAT BELOW

PLAT OF ACREAGE ATTRIBUTABLE TO A WELL IN A PRORATED OR SPACED FIELD

If the intended well is in a prorated or spaced field, please fully complete this side of the form. If the intended well is in a prorated or spaced field complete the plat below showing that the well will be properly located in relationship to other wells producing from the common source of supply. Please show all the wells within 1 mile of the boundaries of the proposed acreage attribution unit for gas wells and within 1/2 mile of the boundaries of the proposed acreage attribution unit for oil wells.

API NO. 15- _____
 OPERATOR _____
 LEASE _____
 WELL NUMBER _____
 FIELD _____



LOCATION OF WELL: COUNTY _____
 _____ feet from South / (North) line of section
 _____ feet from East / (West) line of section
 SECTION _____ TWP _____ RG _____

ACRES ATTRIBUTABLE TO WELL _____
 QTR/QTR/QTR OF ACREAGE _____

IS SECTION XX REGULAR or _____ IRREGULAR
**IF SECTION IS IRREGULAR, LOCATE WELL FROM
 NEAREST CORNER BOUNDARY**
 Section corner used: _____ NE _____ NW _____ SE _____ SW

PLAT

(Show location of the well and shade attributable acreage for prorated or spaced wells.)
 (Show footage to the nearest lease or unit boundary line.)

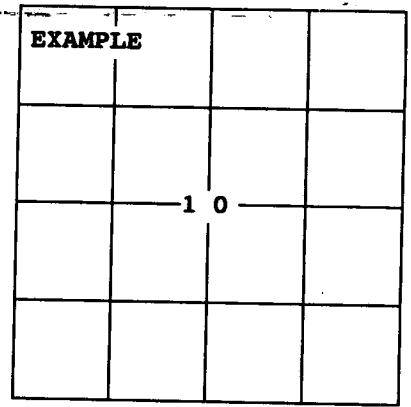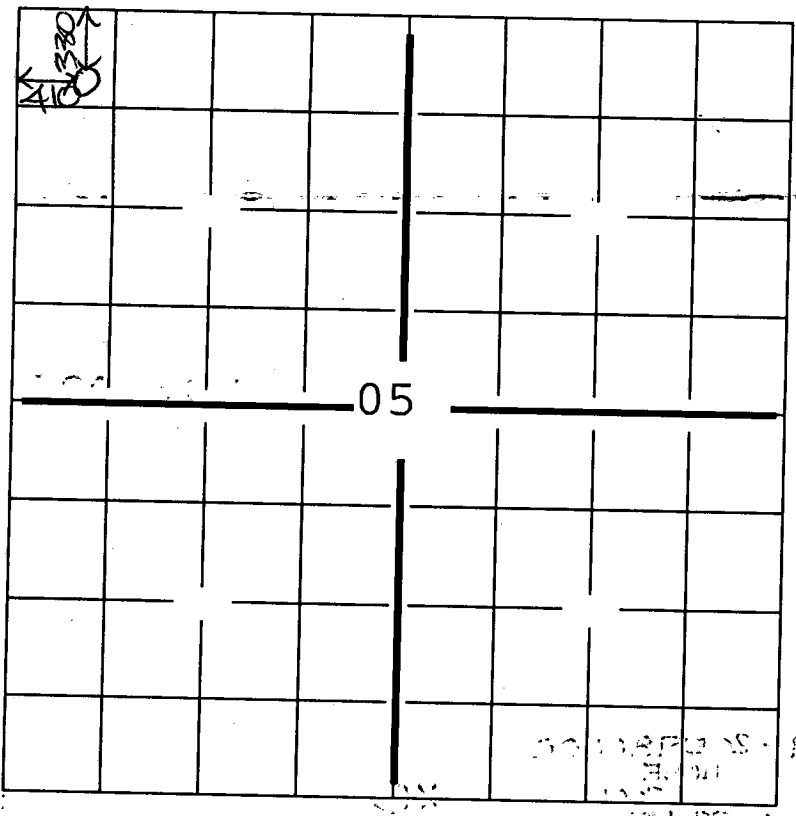

**40
ACRES**

SEWARD CO.

In plotting the proposed location of the well, you must show:

- 1) The manner in which you are using the depicted plat by identifying section lines, i.e. 1 section, 1 section with 8 surrounding sections, 4 sections, etc.;
- 2) the distance of the proposed drilling location from the section's south/north and east/west lines; and
- 3) the distance to the nearest lease or unit boundary line.