

CARD MUST BE TYPED

NOTICE OF INTENTION TO DRILL

State of Kansas
(see rules on reverse side)

CARD MUST BE SIGNED

Starting Date: July 15, 1985
month day year

API Number IS- 109-20,388-00-00

OPERATOR: License # 5181
Name DONALD C. SLAWSON
Address 200 Douglas Building
City/State/Zip Wichita, Kansas 67202
Contact Person Bill Horigan
Phone (316) 263-3201

NE. NW. SE. . . . Sec .32. Twp .13S S, Rge 32W East West
(location)

..2300!..... Ft North from Southeast Corner of Section
..1660!..... Ft West from Southeast Corner of Section
(Note: Locate well on Section Plat on reverse side)

CONTRACTOR: License # 5657
Name SLAWSON DRILLING CO.
City/State Wichita, Kansas

Nearest lease or unit boundary line330!..... feet.
CountyLogan.....

Lease Name Steele Trust !G!..... Well# .1.....

Well Drilled For: Well Class: Type Equipment:
 Oil Swd Infield Mud Rotary
 Gas Inj Pool Ext. Air Rotary
 OWWO Expl Wildcat Cable

Domestic well within 330 feet : yes no
Municipal well within one mile : yes no

If OWWO: old well info as follows:
Operator
Well Name
Comp Date Old Total Depth
Projected Total Depth4600!..... feet
Projected Formation at TDMiss.....
Expected Producing Formations

Depth to Bottom of fresh water1250!..... feet
Lowest usable water formationDakota.....

Depth to Bottom of usable water1500!..... feet
Surface pipe by Alternate : 1 2 #

Surface pipe to be set320!..... feet
Conductor pipe if any required feet

Ground surface elevation2938!..... feet MSL
This Authorization Expires1-11-86.....

Approved By7-11-85.....

I certify that we will comply with K.S.A. 55-101, et seq., plus eventually plugging hole to K.C.C. specifications.

#The production csg will be cmted from below usable wtr to surf. immediately upon completion

Date7/11/85 Signature of Operator or Agent Robert B. Jenkins Title W. KS... District Geologist

RCM for KOHE of the well.

Must be filed with the K.C.C. five (5) days prior to commencing well
 This card void if drilling not started within six (6) months of date received by K.C.C.

*Circulate alternative cementing material per 82-3-106(b)4.


Important procedures to follow :

A Regular Section of Land
 1 Mile = 5,280 Ft.

RECEIVED
 STATE CORPORATION COMMISSION

Notify District office before setting surface casing.

07-11-85 11 1985
 WICHITA DIVISION
 KANSAS

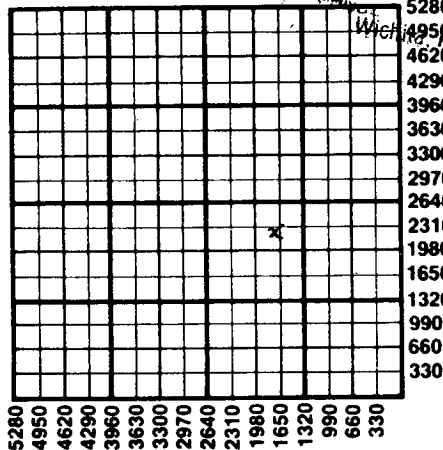

2. Set surface casing by circulating cement to the top.
3. File completion forms ACO-1 with K.C.C. within 90 days of well completion, following instructions on ACO-1, side 1, and including copies of wireline logs.
4. Notify District office 48 hours prior to old well workover or re-entry.
5. Prior to plugging, prepare a plugging plan, then obtain agreement from the appropriate district office for an approved plugging plan.
6. Submit plugging report (CP-4) to K.C.C. after plugging is completed.
7. Obtain an approved injection docket number before disposing of salt water.
8. Notify K.C.C. within 10 days when injection commences or terminates.
- *9. If an alternate 2 completion, cement in the production pipe from below any usable water to surface within 120 days of spud date.

State Corporation Commission of Kansas
 Conservation Division
 200 Colorado Derby Building
 Wichita, Kansas 67202
 (316) 263-3238