

CARD MUST BE TYPED

State of Kansas
NOTICE OF INTENTION TO DRILL

CARD MUST BE SIGNED

(see rules on reverse side)

Starting Date: 12 13 84
month day year

API Number 15- 063 - 20,862 - 00 - 00

OPERATOR: License # 5313
Name F & M OIL CO., INC.
Address 422 Union Center
City/State/Zip Wichita, Kansas 67202
Contact Person R. D. Messinger
Phone (316) 262-2636

C SE NW Sec 10 Twp 13 S, Rge 27W
(location) East West

3300 Ft North from Southeast Corner of Section
3300 Ft West from Southeast Corner of Section
(Note: Locate well on Section Plat on reverse side)

CONTRACTOR: License # 5110
Name B & B Drilling, Inc.
City/State Wichita, Kansas 67202

Nearest lease or unit boundary line 1980 feet.
County Gove
Lease Name Terzick "A" Well# 1

Well Drilled For: Well Class: Type Equipment:
 Oil Swd Infield Mud Rotary
 Gas Inj Pool Ext. Air Rotary
 OWWO Expl Wildcat Cable

Domestic well within 330 feet: yes no
Municipal well within one mile: yes no

If OWWO: old well info as follows:

Operator N/A
Well Name
Comp Date Old Total Depth

Depth to Bottom of fresh water 100 feet
Lowest usable water formation None
Depth to Bottom of usable water 1250 feet

Projected Total Depth 4550 feet
Projected Formation at TD Lansing/KC
Expected Producing Formations Mississippi

Surface pipe by Alternate: 1 2
Surface pipe to be set 350 feet
Conductor pipe if any required
Ground surface elevation feet MSL.
This Authorization Expires 6-4-85
Approved By 12-4-84 R

I certify that we will comply with K.S.A. 55-101, et seq., plus eventually plugging hole to K.C.C. specifications.


Date 12-3-84 Signature of Operator or Agent

R. D. Messinger Title Vice-President
MHC/KOHE 12/4/84

Must be filed with the K.C.C. five (5) days prior to commencing well
This card void if drilling not started within six (6) months of date received by K.C.C.

Important procedures to follow :

**A Regular Section of Land
1 Mile = 5,280 Ft.**

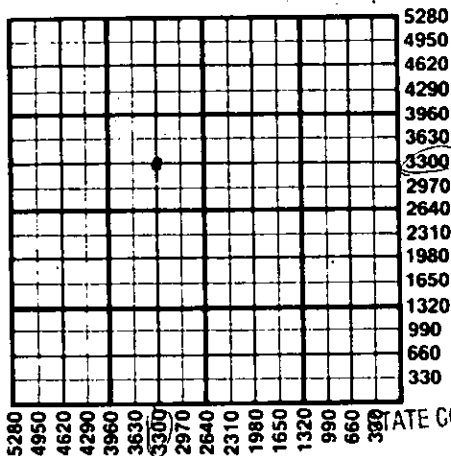

1. Notify District office before setting surface casing.
2. Set surface casing by circulating cement to the top.
3. File completion forms ACO-1 with K.C.C. within 90 days of well completion, following instructions on ACO-1, side 1, and including copies of wireline logs.
4. Notify District office 48 hours prior to old well workover or re-entry.
5. Prior to plugging, prepare a plugging plan, then obtain agreement from the appropriate district office for an approved plugging plan.
6. Submit plugging report (CP-4) to K.C.C. after plugging is completed.
7. Obtain an approved injection docket number before disposing of salt water.
8. Notify K.C.C. within 10 days when injection commences or terminates.
9. If an alternate 2 completion, cement in the production pipe from below any usable water to surface within 120 days of spud date.

RECEIVED

STATE CORPORATION COMMISSION

DEC 04 1984
12-04-84
CONSERVATION DIVISION
Wichita, Kansas

State Corporation Commission of Kansas
Conservation Division
200 Colorado Derby Building
Wichita, Kansas 67202
(316) 263-3238