

CARD MUST BE TYPED

State of Kansas
NOTICE OF INTENTION TO DRILL
(see rules on reverse side)

CARD MUST BE SIGNED

Starting Date: July 11, 1985
month day year

API Number 15-063-20,948-00-00
8.50

OPERATOR: License # 5501
Name Raymond M. Goodin Trust
Address 512 Petroleum Bldg.
City/State/Zip Wichita, Kansas 67202
Contact Person Raymond M. Goodin
Phone 316/262-2192

NW NW NE
(location) Sec. 35. Twp. 13. S, Rge. 30W. East West
4950 Ft North from Southeast Corner of Section
2310 Ft West from Southeast Corner of Section
(Note: Locate well on Section Plat on reverse side)

CONTRACTOR: License # 5302
Name Red Tiger Drilling Company
City/State Wichita, KS, 67202

Nearest lease or unit boundary line 330 feet.
County Gove
Lease Name Rohr Well# 2
Domestic well within 330 feet: yes no
Municipal well within one mile: yes no

Well Drilled For: Well Class: Type Equipment:
 Oil Swd Infield Mud Rotary
 Gas Inj Pool Ext. Air Rotary
 OWWO Expl Wildcat Cable

Depth to Bottom of fresh water 54
Lowest usable water formation 1200 ^{Depth}
Depth to Bottom of usable water 1250 feet
Surface pipe by Alternate: 1 2
Surface pipe to be set 300 feet
Conductor pipe if any required N/A feet
Ground surface elevation Est. 2800 feet MSL.
This Authorization Expires 1-9-86
Approved By 8-9-85

If OWWO: old well info as follows:
Operator
Well Name
Comp Date Old Total Depth
Projected Total Depth 4500 feet
Projected Formation at TD Mississippi
Expected Producing Formations Mississippi Osage

I certify that we will comply with K.S.A. 55-101, et seq., plus eventually plugging hole to K.C.C. specifications.

We will cement the production string from Anhydrite to the surface immediately to RCH/KR
KONE

Date 7-8-85 Signature of Operator or Agent

Raymond M. Goodin Trustee

Must be filed with the K.C.C. five (5) days prior to commencing well
 This card void if drilling not started within six (6) months of date received by K.C.C.

RECEIVED
 STATE CORPORATION COMMISSION


07-08-1985
 JUL 08 1985

A Regular Section of Land
 1 Mile = 5,280 Ft.

Important procedures to follow:

CONSERVATION DIVISION

Wichita, Kansas

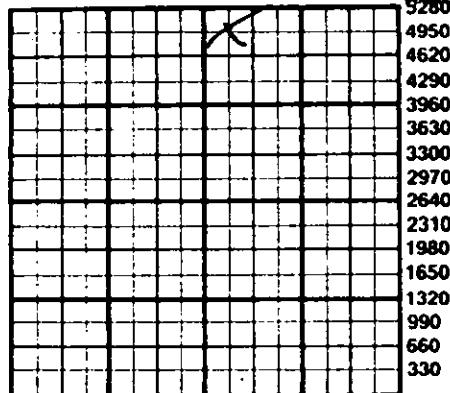

5280
 4950
 4620
 4290
 3960
 3630
 3300
 2970
 2640
 2310
 1980
 1650
 1320
 990
 660
 330

1. Notify District office before setting surface casing.
2. Set surface casing by circulating cement to the top.
3. File completion forms ACO-1 with K.C.C. within 90 days of well completion, following instructions on ACO-1, side I, and including copies of wireline logs.
4. Notify District office 48 hours prior to old well workover or re-entry.
5. Prior to plugging, prepare a plugging plan, then obtain agreement from the appropriate district office for an approved plugging plan.
6. Submit plugging report (CP-4) to K.C.C. after plugging is completed.
7. Obtain an approved injection docket number before disposing of salt water.
8. Notify K.C.C. within 10 days when injection commences or terminates.
9. If an alternate 2 completion, cement in the production pipe from below any usable water to surface within 120 days of spud date.

State Corporation Commission of Kansas
 Conservation Division
 200 Colorado Derby Building
 Wichita, Kansas 67202
 (316) 263-3238