

15-195-20621-00-00


STATE OF KANSAS  
STATE CORPORATION COMMISSION

WELL PLUGGING RECORD

Give All Information Completely  
Make Required Affidavit  
Mail or Deliver Report to  
Conservation Division  
State Corporation Comm.  
245 North Water  
Wichita, KS 67202

Trego County, Sec. 36 Twp. 13S Rge. 21 E/W  
Location as "NE/CNW/SW" or footage from lines  
S/2 NW NE

Lease Owner Mai Operations  
Lease Name Kroeger Well No. #2  
Office Address P.O. Box 33 Russell, Kansas 67665  
Character of Well (Completed as Oil, Gas or Dry Hole)  
Dry Hole

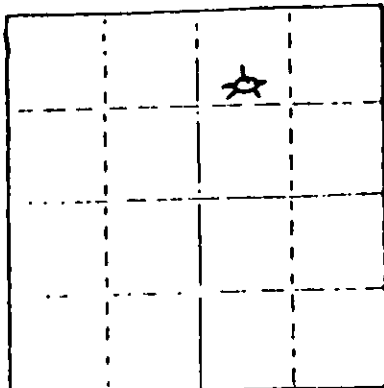

Date Well completed April 15, 1980  
Application for plugging filed April 15, 1980  
Application for plugging approved April 15, 1980  
Plugging commenced April 15, 10:00 P.M. 1980  
Plugging completed April 15, 11:40 P.M. 1980

Reason for abandonment of well or producing formation  
No Commercial Production

If a producing well is abandoned, date of last production  
19

Was permission obtained from the Conservation Division or  
its agents before plugging was commenced? yes

Name of Conservation Agent who supervised plugging of this well Gil Balthazor  
Producing formation Depth to top Bottom Total Depth of Well  
Show depth and thickness of all water, oil and gas formations.

OIL, GAS OR WATER RECORDS

CASING RECORD

LOCATION	CONTENT	FROM	TO	SIZE	PUT IN	PULLED OUT
surface casing	common	0	294.31'	8 5/8"	294.31'	0

Describe in detail the manner in which the well was plugged, indicating where the mud fluid was placed and the method or methods used in introducing it into the hold. If cement or other plugs were used, state the character of same and depth placed, from feet to feet for each plug set.

Plug #1 @ 700' with 60 sxs  
Plug #2 @ 300' with 30 sxs  
Plug #3 @ 40' with 10 sxs  
5 sxs in rathole  
Total of 105 sxs 50-50 poz 6% gel


04-29-1980

(If additional description is necessary, use BACK of this sheet)

Name of Plugging Contractor Pioneer Drilling Company, Inc.  
308 West Mill Plainville, Kansas 67663

STATE OF Kansas COUNTY OF Russell, ss.  
D. E. Wolfe (employee of owner) or (owner/lessee/operator)

of the above-described well, being first duly sworn on oath, says: That I have knowledge of the facts, statements, and matters herein contained and the log of the above-described well as filed and that the same are true and correct. So help me God.

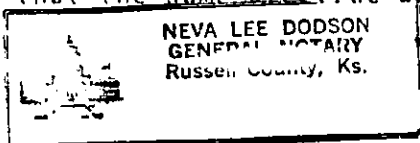

(Signature) D. E. Wolfe  
P. O. Box 33, Russell, Ks 67665  
(Address)

SUBSCRIBED AND SWORN TO before me this 28th day of April, 1980

My commission expires June 5, 1981  
Neva Lee Dodson Notary Public.

15-195-20621-00-00

WELL LOG

OPERATOR: Mai Operations

WELL NAME: Kroeger #2 LOCATION: S/2 NW NE 36-13S-21W

COUNTY: Trego STATE: Kansas

WELL COMMENCED: April 7, 1980 WELL COMPLETED: April 15, 1980

ELEVATION: 2326' K.B. TOTAL DEPTH: 4009'

PRODUCTION: D & A RIG NO: #2

CASING - 8-5/8": 294.31' of 28# used cemented with 170 sxs common 2% gel 3% cc plugdown @ 11:30 P.M. cement circ.  
5-1/2": None

ALL MEASUREMENTS TAKEN FROM THE TOP OF ROTARY BUSHING:

FROM	TO	FORMATION	DEVIATION FROM VERTICAL	REMARKS:
0'	303'	sand and post rock	303' - 3/4 degree	
303'	708'	sand and shale		
708'	1696'	sand and shale		
1660'	1710'	Anhydrite		
1696'	1710'			
1710'	2022'	sand and shale	2022' - 3/4 degree	
2022'	2475'	shale and sand		
2475'	2646'	sand and shale	2646' - 0 degree	
2646'	2652'	lime and shale		
2652'	2864'	shale and lime		
2864'	3027'	lime and shale		
3027'	3179'	lime and shale		
3179'	3320'	shale and lime		
3320'	3439'	shale and lime		
3439'	3592'	lime and shale		
3592'	3680'	shale and lime		
3680'	3747'	lime and shale		
3747'	3842'	lime and shale		
3842'	3880'	lime and shale		
3880'	3890'	lime and shale		
3890'	3975'	lime and shale		
3975'	3990'	shale and lime and sand		
3990'	4002'	lime and chert		
4002'	4009'	lime and shale		
4009'	RTD			

THIS WELL LOG RECEIVED  
APR 29 1980  
KANSAS

STATE OF KANSAS  
COUNTY OF

The undersigned hereby certifies that to the best of his knowledge and belief, the above facts are true and correct

PIONEER DRILLING CO., INC.

By [Signature]

SUBSCRIBED AND SWORN TO, BEFORE ME, THIS 18th day of April, 1980.

[Signature]  
NOTARY PUBLIC

