

15-195-20972-00-00


STATE OF KANSAS
STATE CORPORATION COMMISSION
200 Colorado Derby Bldg.
Wichita, Kansas 67202

Form CP-4
Rev. 12-15-80

WELL PLUGGING RECORD

Give All Information Completely
Make Required Affidavit

COUNTY Trego SEC. 36 TWP. 13S RGE. 21W E/W
Location as in quarters or footage from lines:
2310' FNL & 1650' FEL of NE/4 of Sec. 36, T13S, R21W

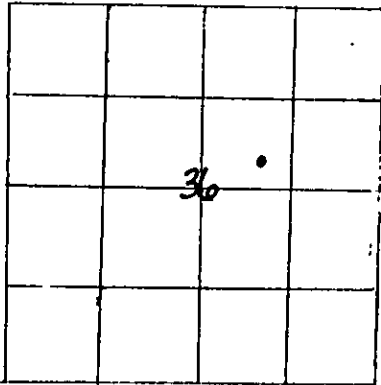

Lease Owner Zenith Petroleum Corporation-Kansas Partnership No. 1
Lease Name Erwin Kroeger Well No. 1
Office Address 7600 W. Tidwell, Suite 502, Houston, TX 77040
Character of Well (Completed as Oil, Gas or Dry Hole): Temporarily Abandoned
Date Well Completed 5-6-82 (Temp. Aban.)
Application for plugging filed 8-25-82; approved 9-13-82
Plugging commenced 10-19-82
Plugging completed 10-19-82
Reason for abandonment of well or producing formation _____

Locate Well
correctly on above
Section Platt.

After testing - not economically productive
Was permission obtained from the Conservation Division or it's
Agent's before plugging was commenced? yes

Name of Conservation Agent who supervised plugging of this well Marion Schmidt
Producing formation Lansing/Kansas Depth to top 3617 bottom 3776 T.D. 4192'
City _____
Show depth and thickness of all water, oil and gas formations.

OIL, GAS OR WATER RECORDS

Casing Record

Formation	Content	From	To	Size	Put in	Pulled Out
DID NOT PRODUCE				5-1/2"	4191'	0
				8-5/8"	365'	0

Describe in detail the manner in which the well was plugged, indicating where the mud fluid was placed and the method or methods used in introducing it into the hold. If cement or other plugs were used, state the character of same and depth placed, from _____ feet to _____ feet for each plug set. Halliburton mixed and pumped cement. Bullheaded down hole as follows:

Between 8-5/8" casing and 5-1/2" casing:
20 sxs cmt 50/50 Pozmix w/4% gel and 4% CaCl2 (1.43 cu.ft. per sack)
Down 5-1/2" casing:
10 sxs cmt slurry (1.43 cu.ft. per sack)
40 sxs cmt slurry (1.43 cu.ft. per sack) with 3 sxs cottonseed hulls
20 hbbs mud, 1/2 sx cottonseed hulls,
20 sxs cmt slurry (1.43 cu.ft. per sack), 10 hbbs mud, rubber plug,
80 sxs cmt slurry (1.43 cu.ft. per sack)
100 sxs cmt slurry (1.43 cu.ft. per sack) with 2 sxs cottonseed hulls to surface
Between 8-5/8" casing and 5-1/2" casing: 130 sxs cmt slurry (1.43 cu.ft./sx) w/3 sxs cotton-
(If additional description is necessary, use BACK of this sheet) seed hulls

Name of Plugging Contractor Halliburton Services
Colorado Derby Bldg., Suite 600, Wichita, Kansas 67202

STATE OF Texas COUNTY OF Harris, ss.

E. B. Rogers, Jr. (employee of owner) or (owner or operator) of the above-described well, being first duly sworn on oath, says: That I have knowledge of the facts, statements, and matters herein contained and the log of the above-described well as filed and that the same are true and correct. So help me God.

STATE CORPORATION COMMISSION
NOV 12 1982

(Signature) E. B. Rogers Jr.
7600 W. Tidwell, Suite 502, Houston, TX 77040 (Address)

SUBSCRIBED AND SWORN TO before me this 9th day of November, 19 82

Cheryl R. McPherson
Notary Public.

My Commission expires: 6-1-86

CHERYL L. MCPHERSON
Notary Public in and for State of Texas
My Commission Expires 6-1-86