


STATE OF KANSAS  
STATE CORPORATION COMMISSION

WELL PLUGGING RECORD

Give All Information Completely  
Make Required Affidavit  
Mail or Deliver Report to  
Conservation Division  
State Corporation Comm.  
245 North Water  
Wichita, KS 67202

Trego County, Sec. 36 Twp. 13 Rge. 21 E/W  
Location as "NE/CNW $\frac{1}{4}$ SW $\frac{1}{4}$ " or footage from lines SE SE SE

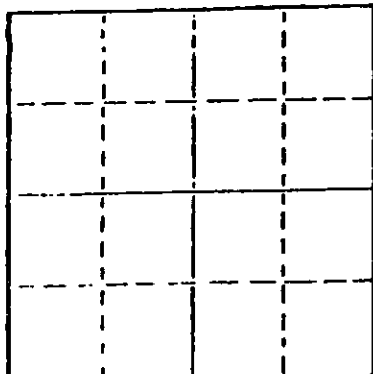

Locate well correctly on above Section Plat

Lease Owner Shields Oil Producers, Inc.  
Lease Name Fisher Well No. 1  
Office Address Shields Bldg., Russell, Kansas 67665  
Character of Well (Completed as Oil, Gas or Dry Hole) Dry hole  
Date Well completed 9-4 1977  
Application for plugging filed 9-4 1977  
Application for plugging approved 9-4 1977  
Plugging commenced 9-4 1977  
Plugging completed 9-4 1977  
Reason for abandonment of well or producing formation Dry hole

If a producing well is abandoned, date of last production 19

Was permission obtained from the Conservation Division or its agents before plugging was commenced? Yes

Name of Conservation Agent who supervised plugging of this well Gilbert Balthazor  
Producing formation \_\_\_\_\_ Depth to top \_\_\_\_\_ Bottom \_\_\_\_\_ Total Depth of Well 13,588'  
Show depth and thickness of all water, oil and gas formations.

OIL, GAS OR WATER RECORDS

CASING RECORD

FORMATION	CONTENT	FROM	TO	SIZE	PUT IN	PULLED OUT
				8 5/8"	264'	Cmtd. w/175 sax

Describe in detail the manner in which the well was plugged, indicating where the mud fluid was placed and the method or methods used in introducing it into the hold. If cement or other plugs were used, state the character of same and depth placed, from \_\_\_\_\_ feet to \_\_\_\_\_ feet for each plug set.

Fill hole w/heavy mud 09 20-1977  
Push bridge plug to 660'  
Spot 60 sax cement on plug thru 4 1/2" drill pipe  
Push bridge plug to 240'  
Spot 20 sax cement on plug thru 4 1/2" drill pipe  
Push bridge plug to 40' w/1/2 sax hulls on plug  
Dump 10 sax cement on plug to cellar  
Dump 2 sax cement in rat hole and mouse hole

(If additional description is necessary, use BACK of this sheet)

Name of Plugging Contractor Shields Drilling Co., Inc.

STATE OF KANSAS COUNTY OF RUSSELL, ss.  
R.L. Shields (owner or operator)  
of the above-described well, being first duly sworn on oath, says: That I have knowledge of the facts, statements, and matters herein contained and the log of the above-described well as filed and that the same are true and correct. So help me God.

(Signature) R.L. Shields  
Shields Bldg., Russell, Kansas  
(Address)

SUBSCRIBED AND SWORN TO before me this 16th day of September, 1977

Rush Phillips  
Notary Public.

My commission expires May 26, 1979



# Shields


15-195-20431-00-00

Russell, Kansas

## WELL LOG

Operator: Shields Oil Producers, Inc.  
 Well: Fisher #1  
 Commenced: August 29, 1977  
 Completed: September 5, 1977  
 Contractor: Shields Drilling Co., Inc.

Well Description: SE SE SE  
 Sec. 36-13S-21W  
 Trego Co., Kansas

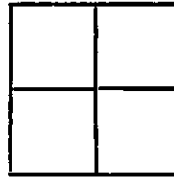

Elevation: 2,277' KB  
 Treatment:  
 Production: D & A  
 Tops:

### CASING RECORD

Size	Run	Pulled
8 5/8"	264'	Cmtd. w/175 sax

..... Figures Indicate Bottom of Formations .....

Surface clay, sand & post rock	50'
Shale & sand	245'
Shale	532'
Sand	630'
Shale	1,325'
Sand	1,350'
Shale	1,417'
Redbed	1,616'
Anhydrite	1,666'
Shale & shells	2,113'
Shale & lime	2,520'
Lime	2,803'
Lime & shale	3,245'
Lime	3,377'
Lime & shale	3,497'
Lime	3,588'    RTD

09-20-1977

Notes