


STATE OF KANSAS
 STATE CORPORATION COMMISSION
 Give All Information Completely
 Make Required Affidavit
 Mail or Deliver Report to:
 Conservation Division
 State Corporation Commission
 800 Bitting Building
 Wichita, Kansas

15-195-00193-00-00
WELL PLUGGING RECORD

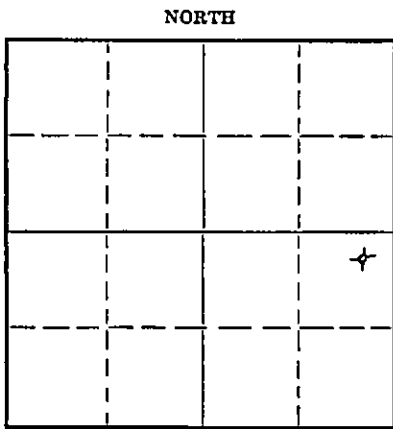

Locate well correctly on above Section Plat

Trego County. Sec. 2 Twp. 13S. Rge. 22 (W)
 Location as "NE/CNW $\frac{1}{4}$ SW $\frac{1}{4}$ " or footage from lines NE. NE. SE.
 Lease Owner Peel-Hardman
 Lease Name King Well No. 1
 Office Address P. O. Box 359, Hoisington, Kansas
 Character of Well (completed as Oil, Gas or Dry Hole) Dry Hole
 Date well completed June 16 19 51
 Application for plugging filed June 16 19 51
 Application for plugging approved June 16 19 51
 Plugging commenced June 16 19 51
 Plugging completed June 16 19 51
 Reason for abandonment of well or producing formation Dry Hole
 If a producing well is abandoned, date of last production 19
 Was permission obtained from the Conservation Division or its agents before plugging was commenced?

Name of Conservation Agent who supervised plugging of this well E. R. Petty, Hays, Kansas
 Producing formation Depth to top Bottom Total Depth of Well 4177 Feet
 Show depth and thickness of all water, oil and gas formations.

OIL, GAS OR WATER RECORDS

CASING RECORD

Formation	Content	From	To	Size	Put In	Pulled Out
		0	208'	8 5/8"	208'	None

Describe in detail the manner in which the well was plugged, indicating where the mud fluid was placed and the method or methods used in introducing it into the hole. If cement or other plugs were used, state the character of same and depth placed, from feet to feet for each plug set.

4177' - 201 $\frac{1}{2}$ ' - Heavy Rotary Mud
 201 $\frac{1}{2}$ ' - 200' - Wooden Plug
 200' - 154' - 15 Sacks Cement
 154' - 36 $\frac{1}{2}$ ' - Heavy Rotary Mud
 36 $\frac{1}{2}$ ' - 35' - Wooden Plug
 35' - 6' - 1/2 sack hulls & 10 Sacks Cement
 6' - Surface - Celler

STATE OF KANSAS
 RECEIVED
 07-07-51

(If additional description is necessary, use BACK of this sheet)
 Correspondence regarding this well should be addressed to Peel-Hardman 951
 Address P. O. Box 359, Hoisington, Kansas

STATE OF KANSAS, COUNTY OF BARTON, ss.
 Peel-Hardman (owner or operator) of the above-described well,
 being first duly sworn on oath, says: That I have knowledge of the facts, statements, and matters herein contained and the log of the above-described well as filed and that the same are true and correct. So help me God.

(Signature) PEEL-HARDMAN
 BY: *Wm Herbert*
 (Address)

SUBSCRIBED AND SWORN to before me this 30th day of June, 19 51

Marion M. Herbert
 Notary Public.

My commission expires June 4, 1955

PLUGGING
 FILE SEC 2 T 13 R 22
 BOOK PAGE 90 LINE 24

15-195-00193-00-00

DRILLER'S LOG

Company: Peel-Hardman
N. Appleman Company

NE NE SE
Sec. 2, Twp. 13S, Rge. 22W

Farm: King Well No. 1
Total Depth: 4177'

County: Trego,
Kansas

Comm: 6-5-51 Comp: 6-16-51
Contractor: Peel-Hardman

Elevation:

Casing: 8 5/8" 208' cem.

Production: Dry

Figures below indicate bottom of formations

Surface Clay	0 -	206
Shale		900
Sand		1005
Shale		1125
Sand		1410
Sand & Shale		1590
Red Bed & Shale		1703
Anhydrite		1743
Shale & Shells		2680
Lime		2715
Shale		3320
Shale & Shells		3510
Lime		4035
Cherty Lime		4177
Total Depth		4177

This is to certify that the above information is, to the best of our knowledge true and correct.

PEEL-HARDMAN

BY: *Wm. Herbert*

SUBSCRIBED AND SWORN to before me this 30th day of June, 1951

My commission expires June 4, 1955 *Marion M. Herbert*

07-02-1951

PLUGGING
FILE SEC 2 T 13 R 22 W
BOOK PAGE 99 LINE 24